


T.2N.R.33E.W.M.

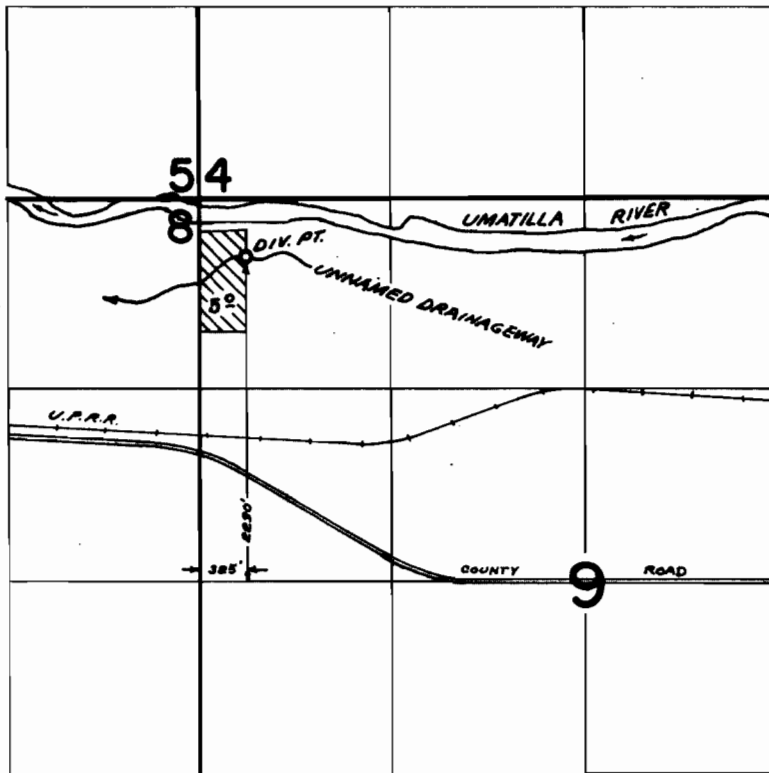

FINAL PROOF SURVEY
UNDER

Application No. 46039 Permit No. 34381
IN NAME OF

J. B. NEWSOME

Surveyed Apr. 16 1973, by D. M. NORBY