


T.3N., R.36E., W.M.

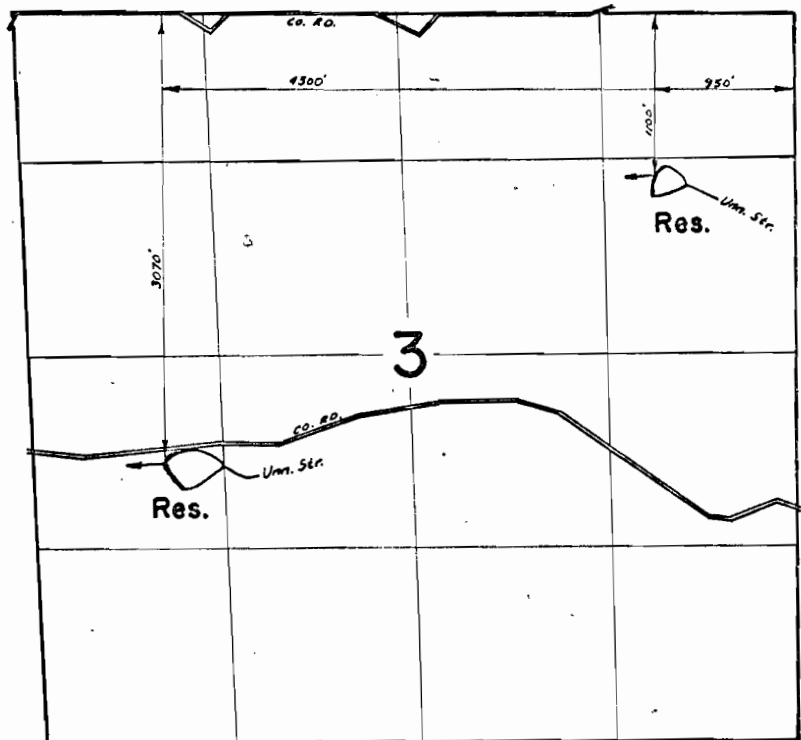

FINAL PROOF SURVEY
UNDER

Application No. R-46044 R-5474
R-46045 Permit No. R-5475
IN NAME OF

JOHNS, SMITH AND BEAMER

Surveyed April 18, 1973, by D. Norby