


T.2S.R.38E.W.M.

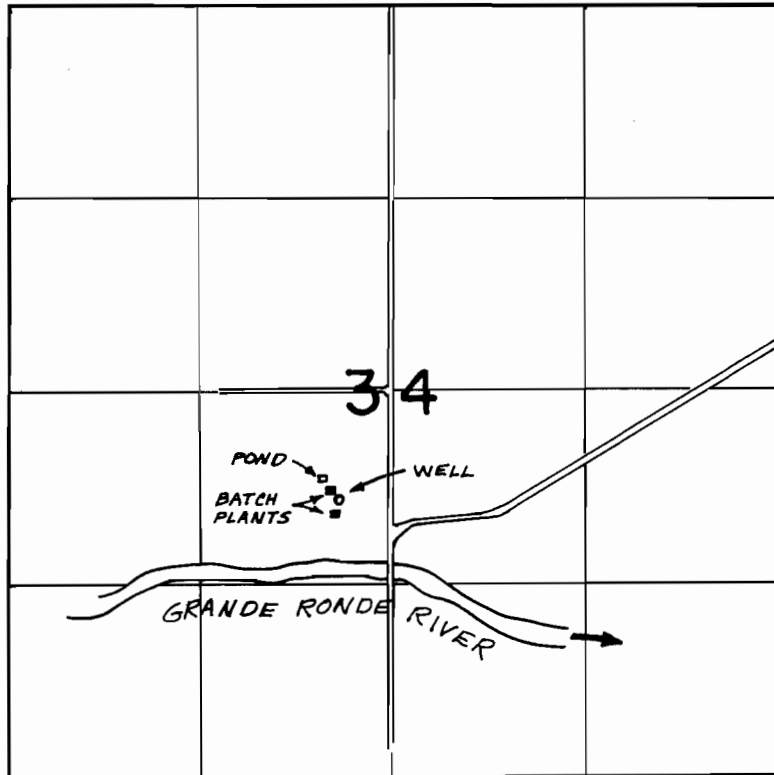

WELL - 750' S., 350' W. FROM CENTER SECTION 34

FINAL PROOF SURVEY
UNDER

Application No. G-4003 Permit No. G-3755
IN NAME OF

O.K. ROGERS
dba: **ROGERS ASPHALT and PAVING**
Surveyed July 16, 1973, by R. MUCKEN