


T.3S. R.39E. W.M.

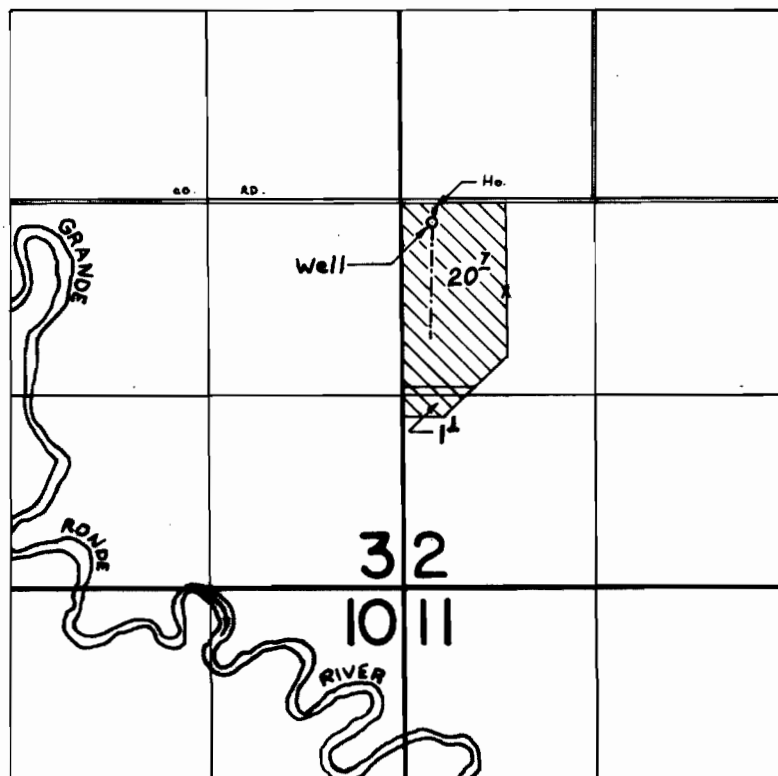

Well Located: 140' S. & 210' E. from W. 1/4 cor. Section 2

FINAL PROOF SURVEY
UNDER

Application No. G-4833 Permit No. G-4556
IN NAME OF

EVERETT L. HAMANN

Surveyed JULY 19, 1973, by R. G. MUCKEN