


T.1S. R.39E. W.M.

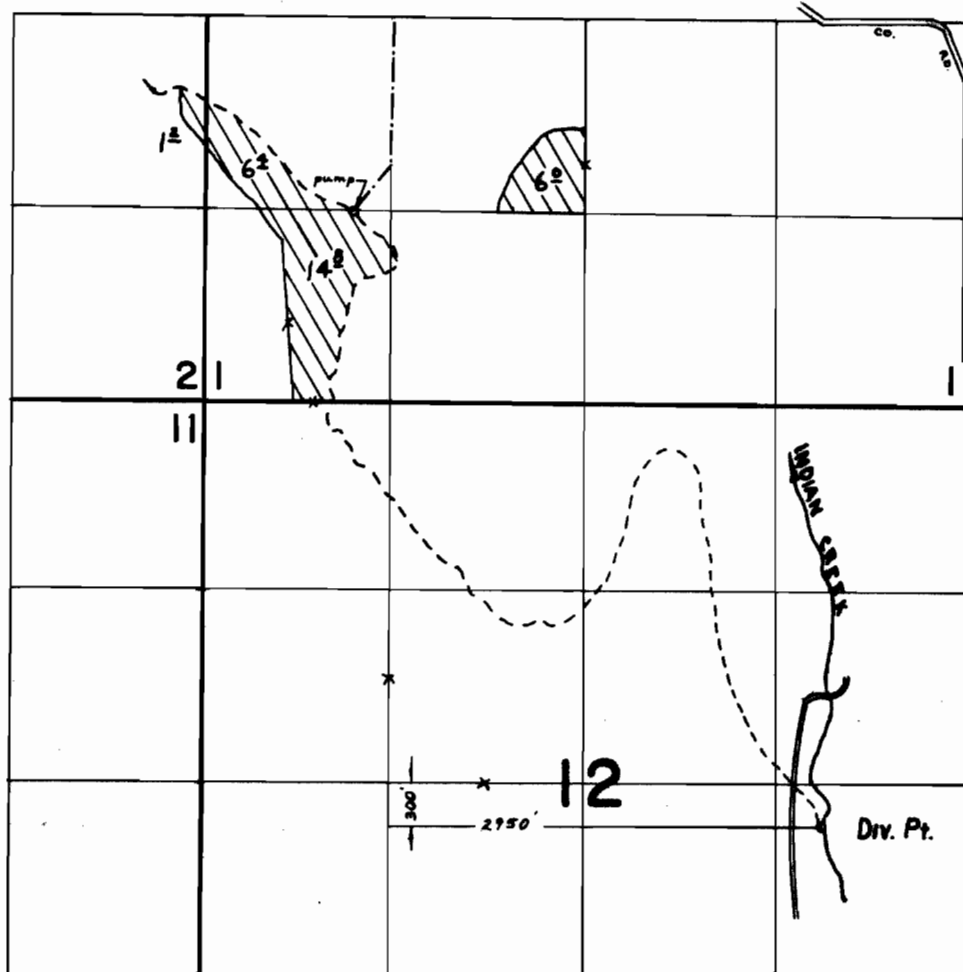

FINAL PROOF SURVEY
UNDER

Application No. 42793 Permit No. 31994
IN NAME OF

Earl & Necho Torbell

Surveyed JULY 13, 1973, by R.G. MUCKEN