


T.1S. R.38E. W.M.

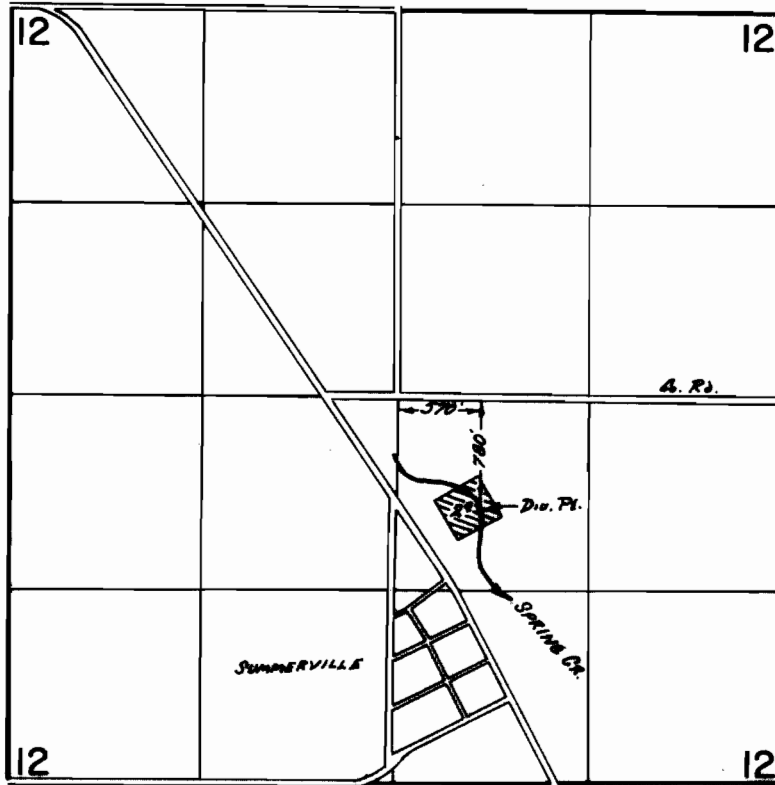

FINAL PROOF SURVEY
UNDER

Application No. 46660 Permit No. 34861
IN NAME OF

Conley Fitchett

Surveyed JULY 14 1979, by R. B. MUCKEN