
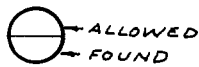


# T.2S.R.44&45E.W.M.

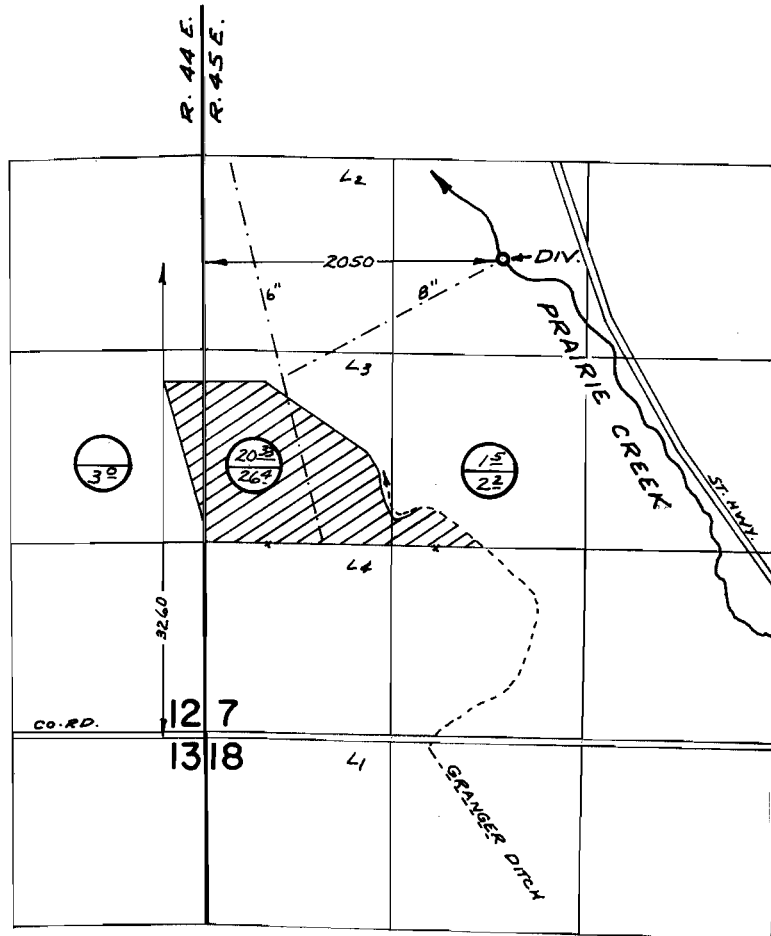

## FINAL PROOF SURVEY UNDER

Application No. 41633 Permit No. 31200  
IN NAME OF

E. JUSTIN SNYDER

Surveyed JULY 31, 1973, by R. MUGGEN