


T.2N. R.48E. W.M.

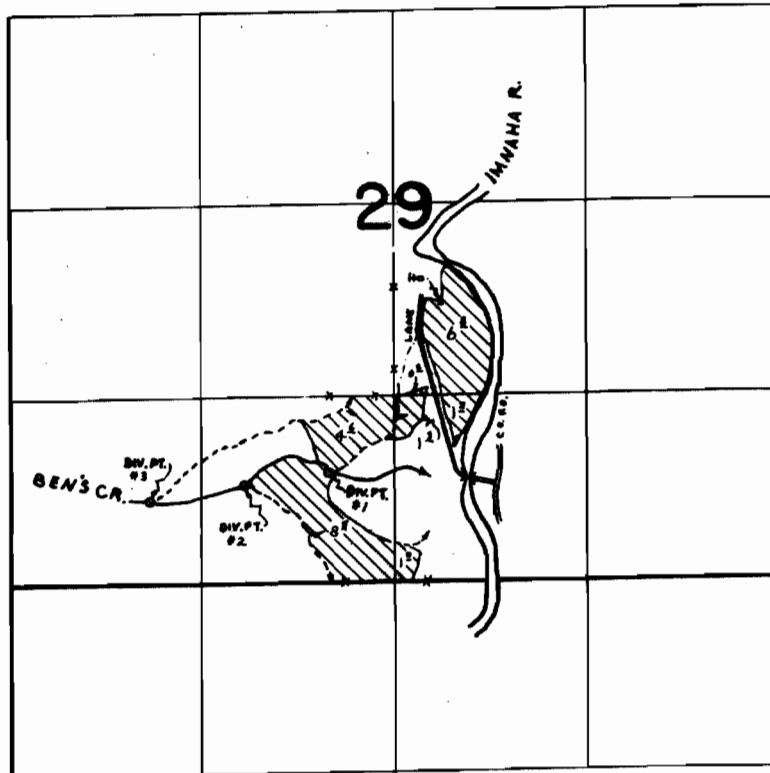

Div. Pts. Loc: #1- 520'S. & 460'W., #2- 620'S. & 1040'W., #3- 730'S. & 1680'W.
all From SW. cor. NW 1/4 SE 1/4 Sec. 29

FINAL PROOF SURVEY
UNDER

Application No. 43516 Permit No. 32545
IN NAME OF

JERALD WITHERITE

Surveyed AUG. 6, 1973, by R. MUCKEN