


T.1N. R.48E. W.M.

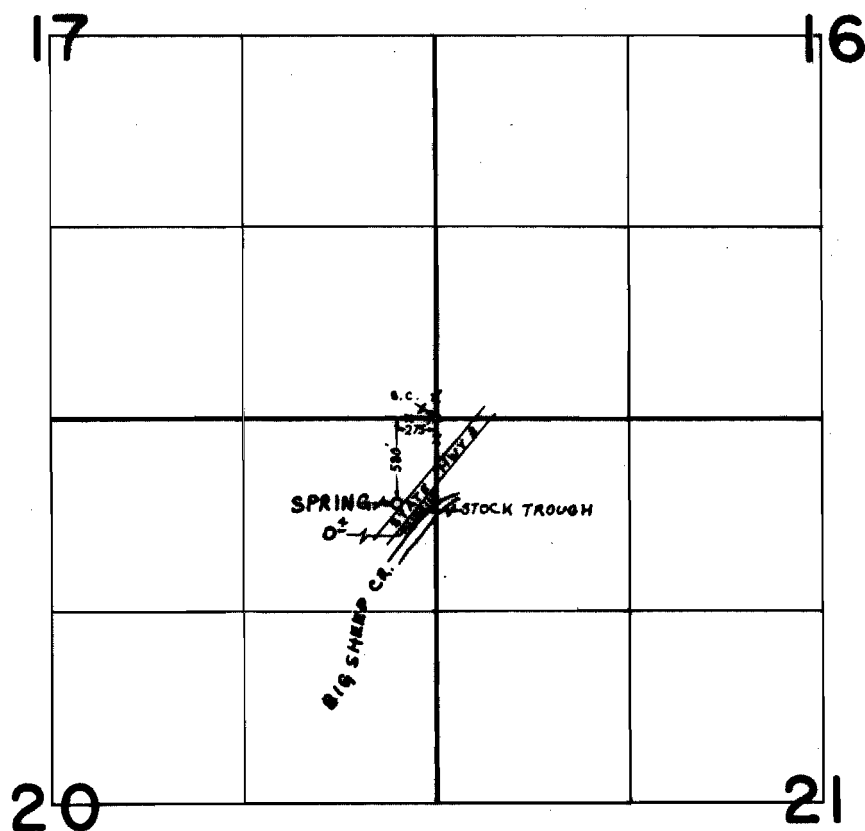

FINAL PROOF SURVEY UNDER

Application No. 45547 Permit No. 33982

IN NAME OF

A. L. DUCKETT

Surveyed AUGUST 3, 1973, by R. MUCKEN

G.A.F.
1973-L