


T.3N.R.45E.W.M.

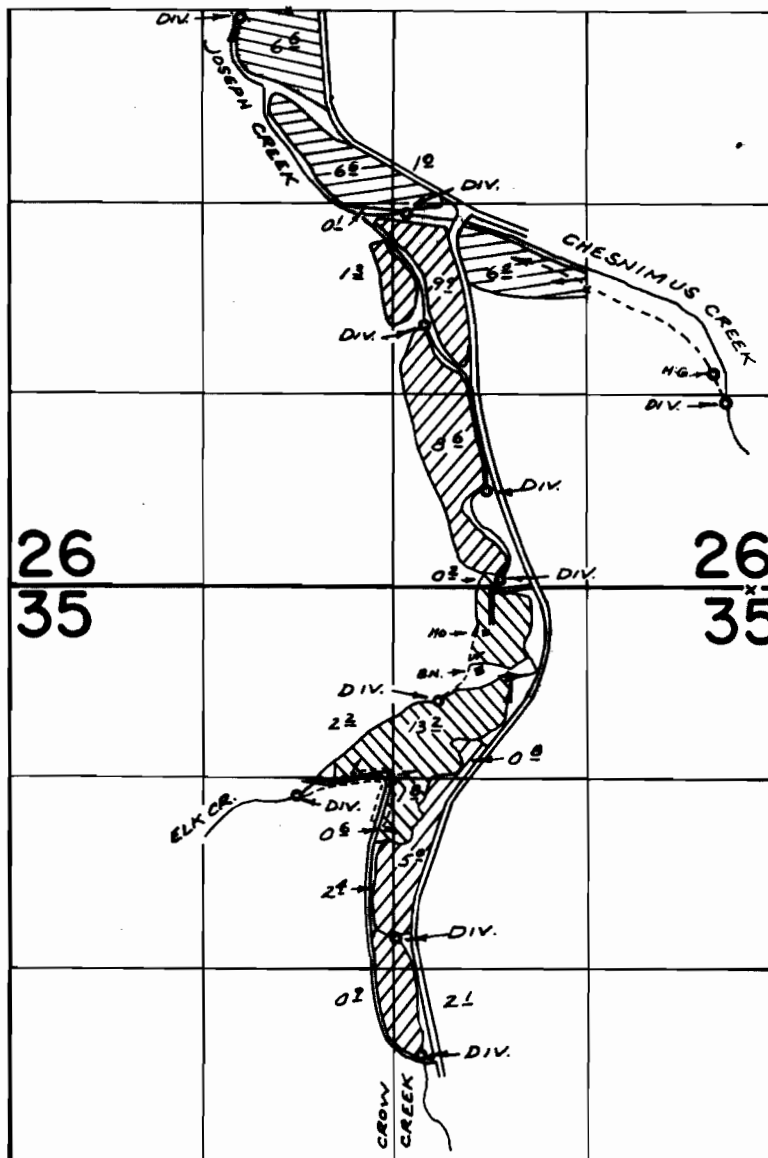

DIV. PTS. LOC: CHESNIMUS CR. - 2560'N & 2550'W; 1270'N & 370'W;
 JOSEPH CR. - 3910'N & 3700'W;
 CROW CR. - 1800'N & 2430'W; 670'N & 2000'W;
 50'N & 1910'W; 2420'S & 2620'W; 3220'S & 2450'W;
 ELK CR. - 780'S & 2330'W; 1430'S & 3300'W, ALL
 FROM N.E. COR. SEC. 35

CHESNIMUS CR. →



JOSEPH CR. →



ELK CR. →



CROW CR. →



FINAL PROOF SURVEY UNDER

Application No. 44310 Permit No. 33090
 IN NAME OF

MACK BIRKMAIER

Surveyed AUG. 8, 1973, by R. MUCKEN