


T.3S.R.46E.W.M.

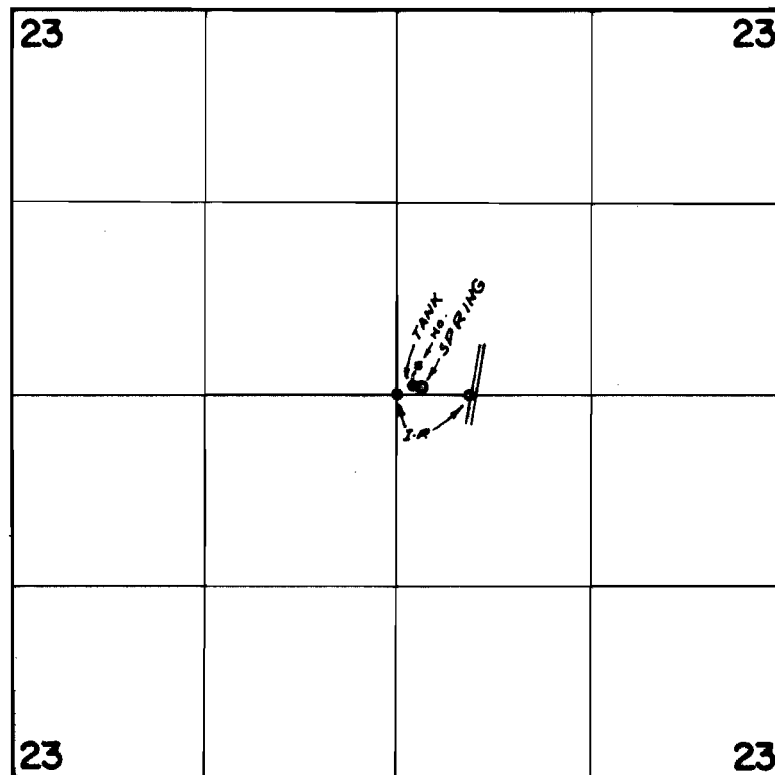

SPRING LOC: 50' N & 170' E FROM CEN. SEC. 23

FINAL PROOF SURVEY
UNDER

Application No. 45797... Permit No. 34180..
IN NAME OF

FRED G. JOHNSON & MABEL M. JOHNSON

Surveyed AUG. 2, 1973, by R. MUGGEN