


T.1S.,R.43E.,W.M.

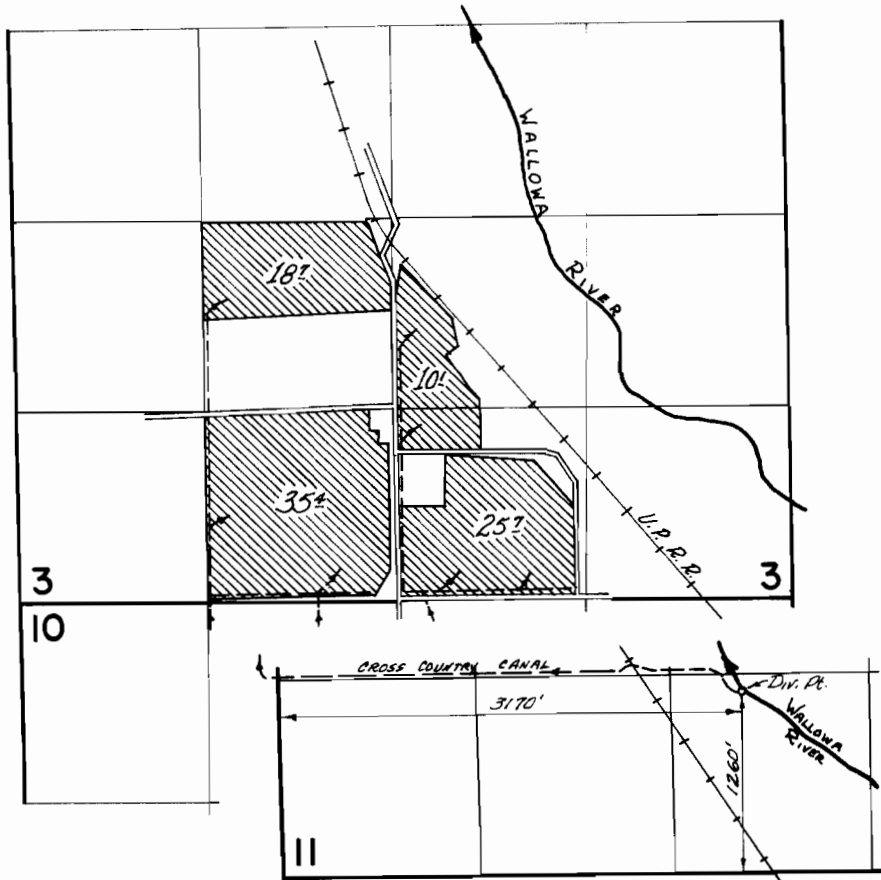

**FINAL PROOF SURVEY**  
UNDER

Transfer No. H-200

Application No. 46551 Permit No. 34777

IN NAME OF

HAUN BROTHERS (JOSEPH & JAMES HAUN)

Surveyed AUG. 9 1973, by D. NORBY