


# T.3S.R.45E.W.M.

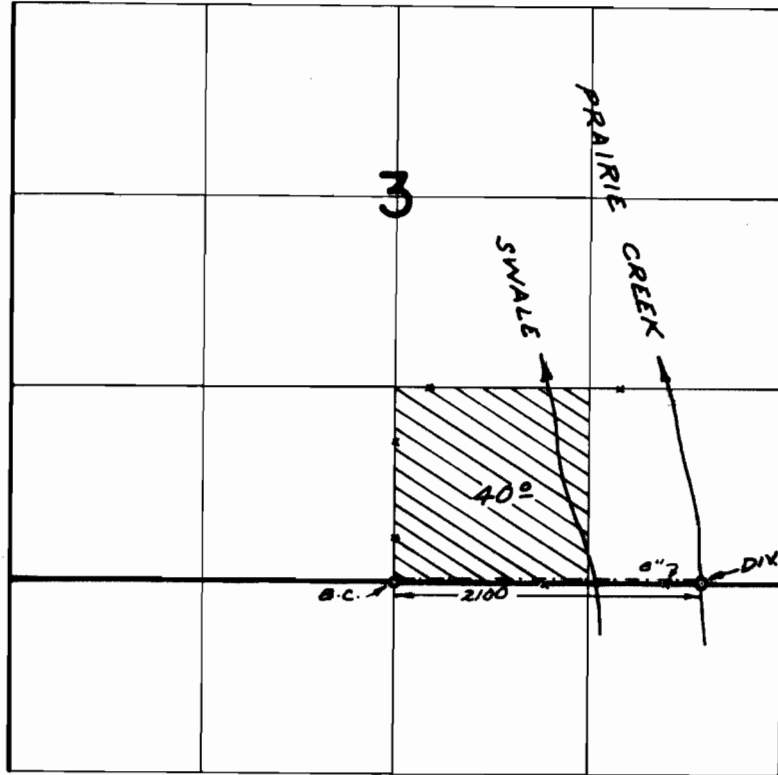

## FINAL PROOF SURVEY UNDER

Application No. 42425 Permit No. 36519  
IN NAME OF

.....JOHN PRAG.....

Surveyed AUG. 2, 1973, by R. MUCKEN