


T.2S.,R.44E.,W.M.

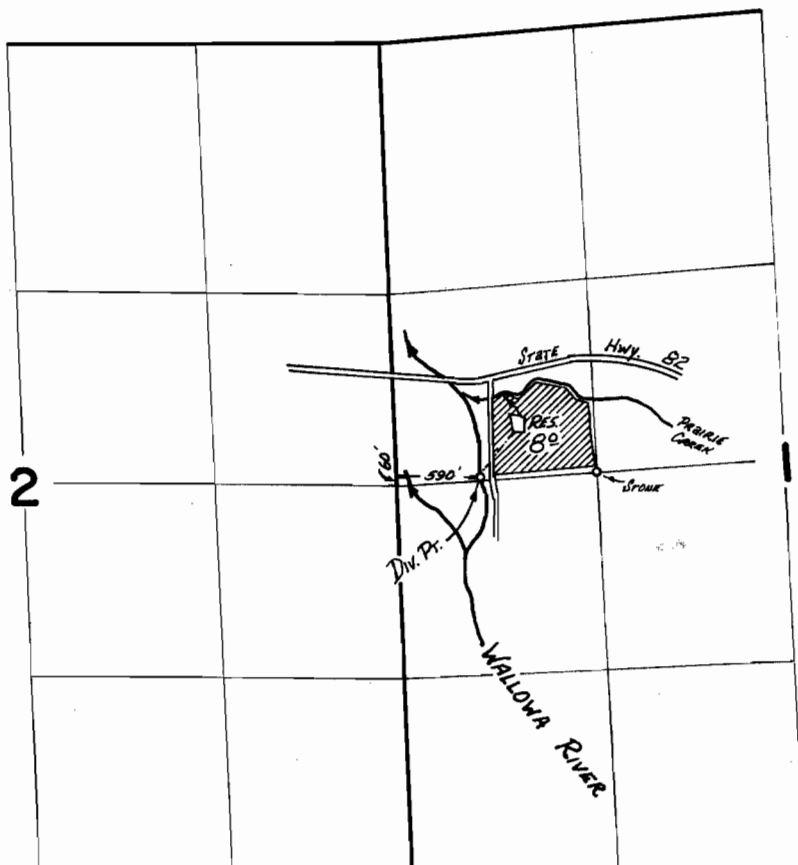

FINAL PROOF SURVEY
UNDER

R-49375 R-5840
Application No. 49282 Permit No. 36082
IN NAME OF

LORIN M. RICKER

Surveyed Aug. 7 1973, by D. NORBY