


T.2 & 3 S. R. 45 E. W.M.

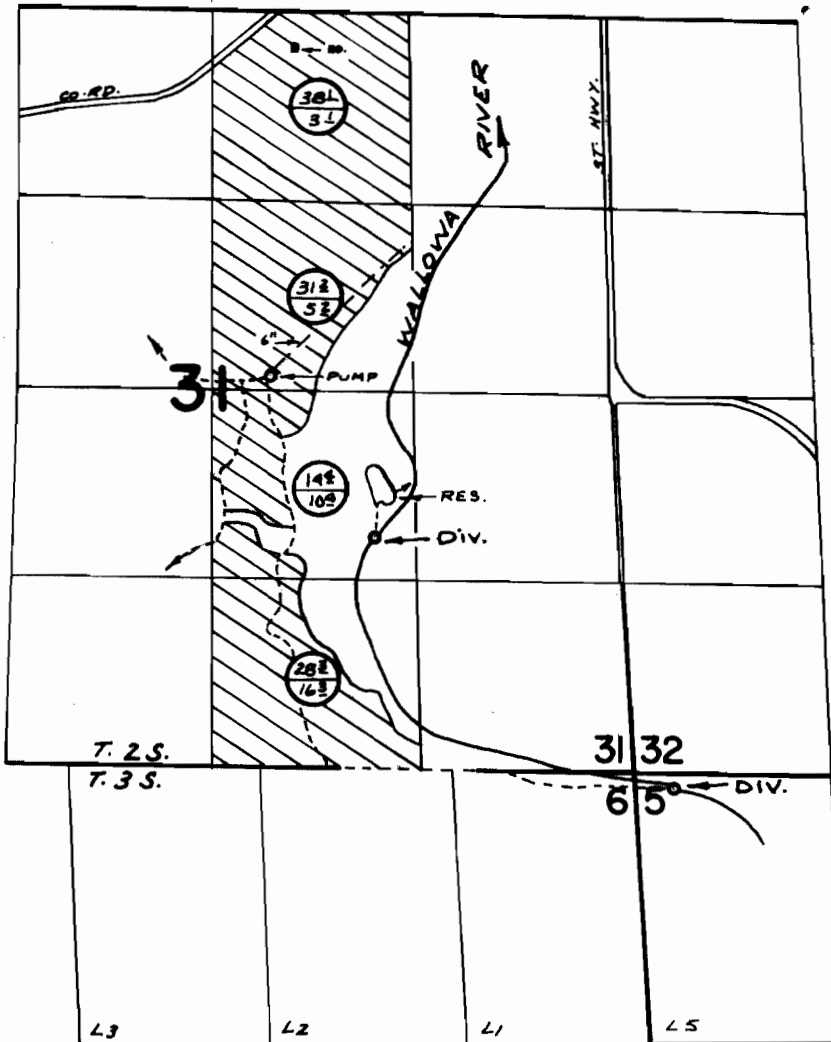

FOUND
ALLOWED UNDER PERMIT 32228

DIV. PTS. LOC: RIVER - 100'S. & 270'E ; RES. (OFF-CHANNEL) - 1580'N &
1800'W, BOTH FROM S.E. COR. SEC. 31

FINAL PROOF SURVEY UNDER

43142

32228

Application No. R-50252 Permit No. R-6029
50252 37133
IN NAME OF

KIRK HAYES

Surveyed AUG. 2, 1973. by R. MUGGEN