


T.2&3S.R.45E.W.M.

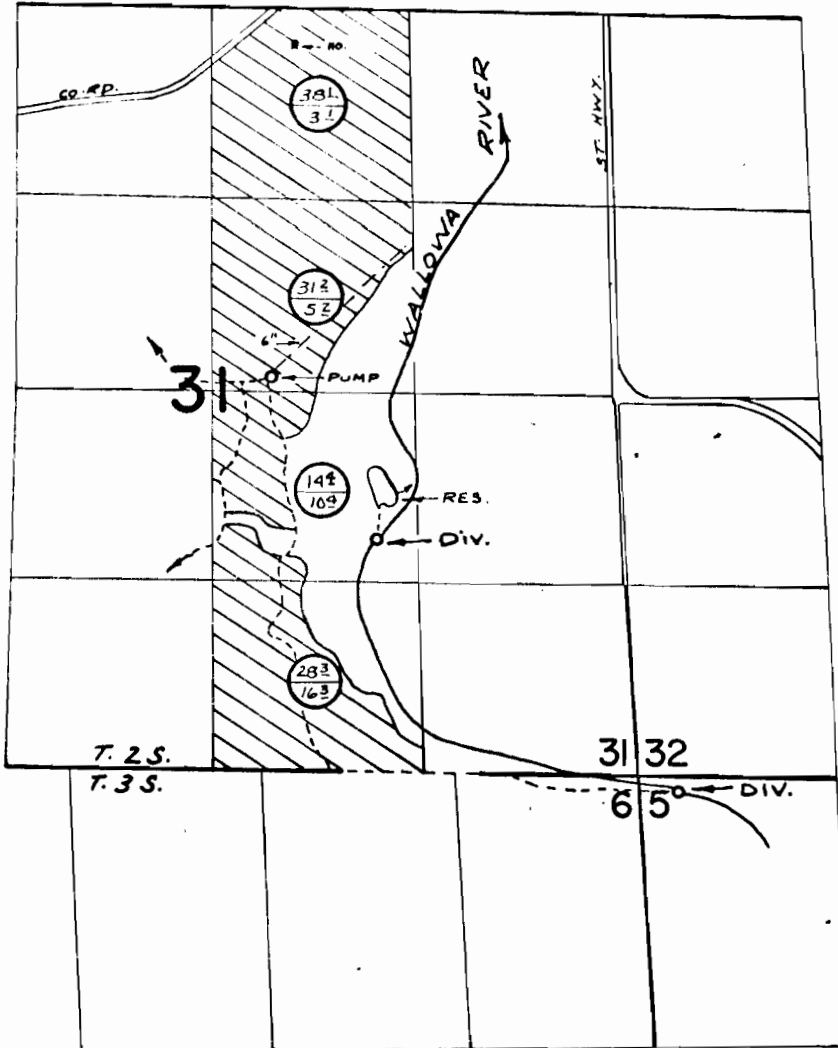

FOUND
ALLOWED UNDER PERMIT 32228

DIV. PTS. LOC: RIVER - 100'S. & 270'E; RES. (OFF-CHANNEL) - 1500'N &
1800'W., BOTH FROM S.E. COR. SEC. 31

FINAL PROOF SURVEY UNDER

43142

32228

R-50252

Application No. 50253 Permit No.
IN NAME OF

.....KIRK HAYES.....

Surveyed AUG. 2, 1973. by R. MURKIN.