


T. 7 N. R. 4 W. W.M.

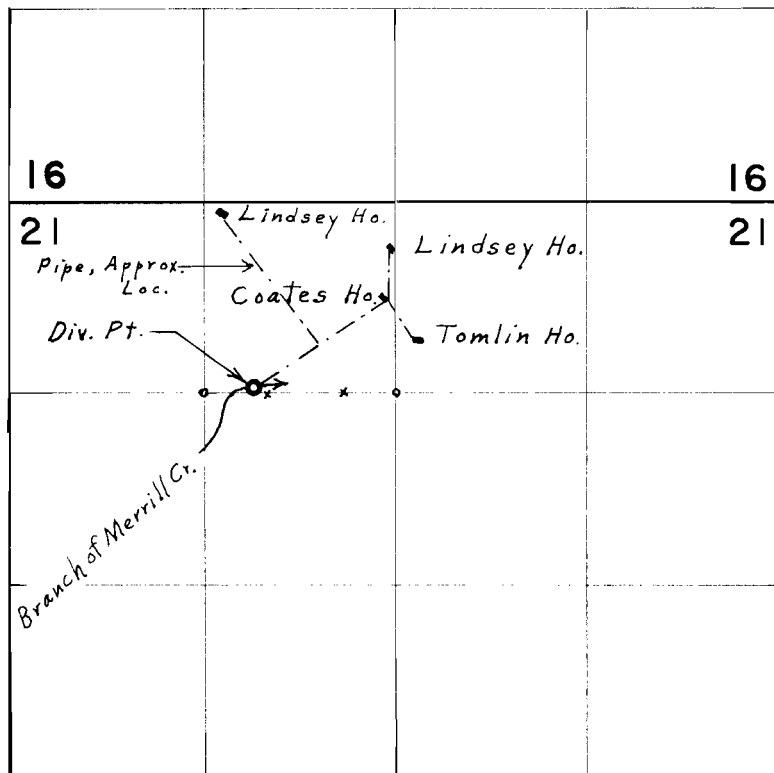

Div. Pt. located 40' N. & 340' E. from S.W. Cor. N.E. $\frac{1}{4}$ N.W. $\frac{1}{4}$ Sec. 21

FINAL PROOF SURVEY
UNDER

Application No. 46007, Permit No. 34361
IN NAME OF

WILLIAM W. COATES

Surveyed July 12, 1973, by L. E. Gould.