


T. 7 N. R. 4 W. W.M.

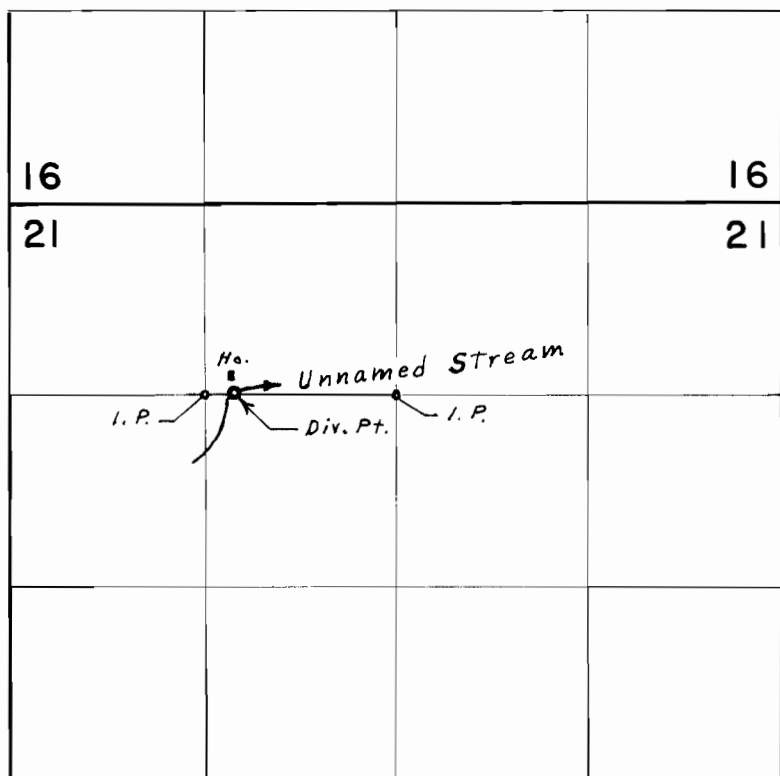

Div. Pt. located 10' N. & 180' E. from S.W. Cor. N.E. $\frac{1}{4}$ N.W. $\frac{1}{4}$ Sec. 21

FINAL PROOF SURVEY UNDER

Application No. 46581 Permit No. 34406
IN NAME OF

STEPHEN M. GASKILL, SR.

Surveyed July 12, 1973, by L. E. Gould