


T.23S. R.4W. W.M.

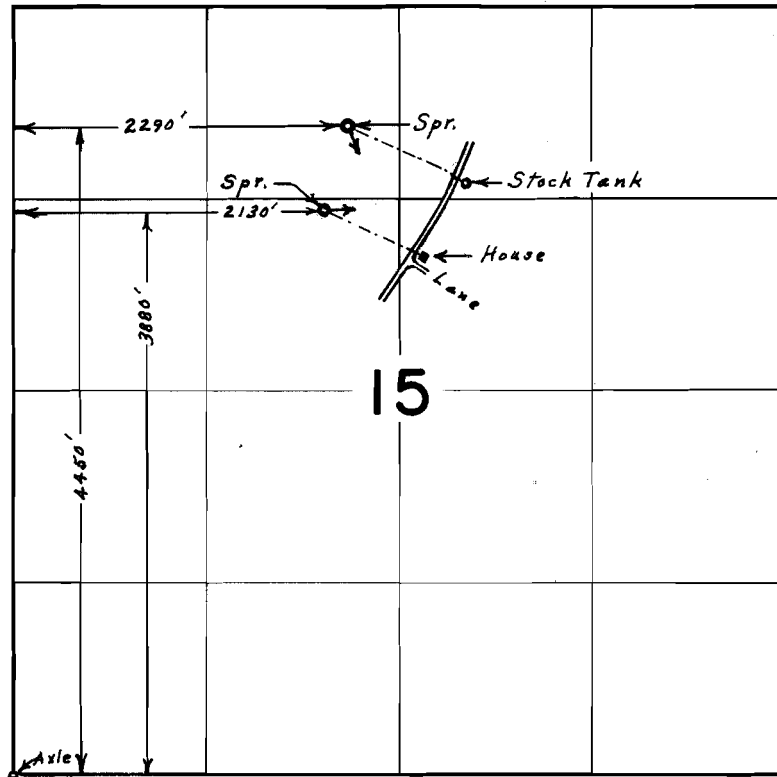

FINAL PROOF SURVEY
UNDER

Application No. 44351 Permit No. 33241
IN NAME OF

LEONARD A. & LILLIAN C. KUK

Surveyed April 6, 1973, by L. E. Gould