


T. 26 S. R. 6 W. W.M.

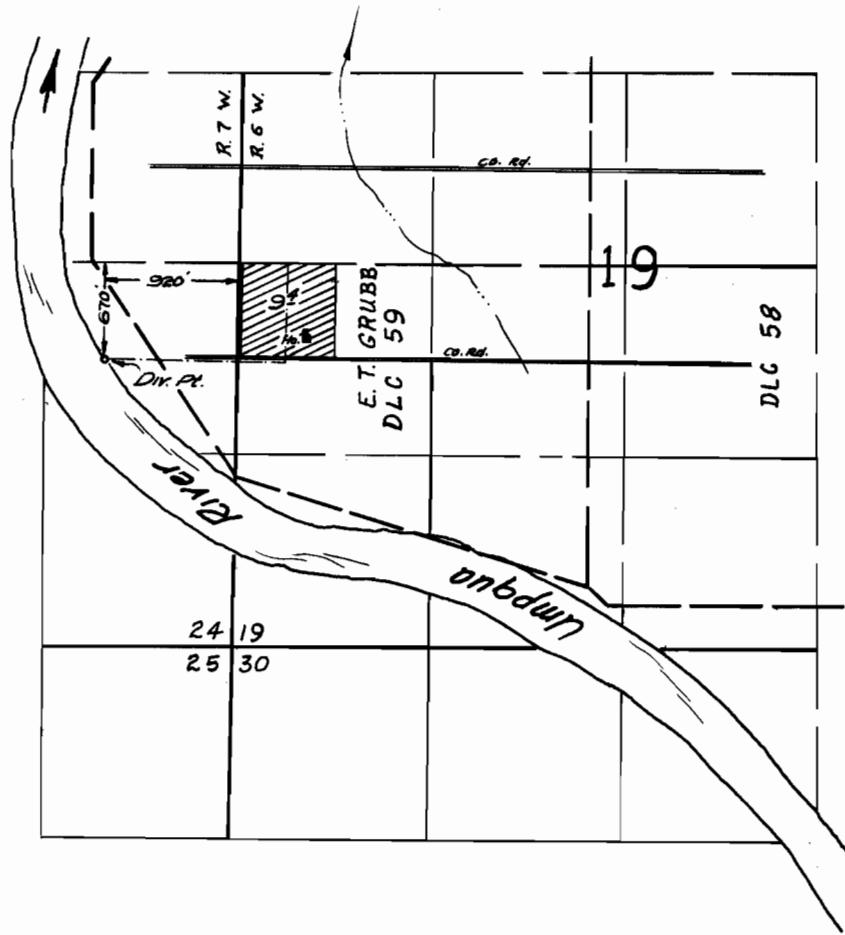

FINAL PROOF SURVEY UNDER

Application No. 44638 Permit No. 33393
IN NAME OF

MR. & MRS. ROBERT AND GLADYS BUDELL

Surveyed MAY 2, 1972, by DAVID M. NORBY