


T. 24 S. R. 7 W. W.M.

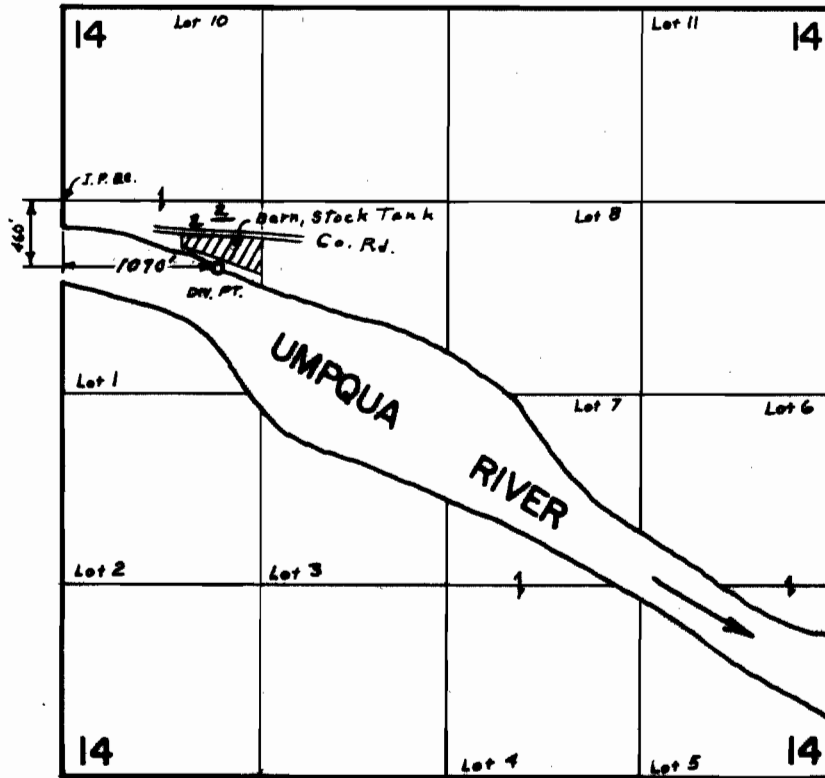

FINAL PROOF SURVEY
UNDER

Application No. 45798 Permit No. 34181
IN NAME OF

LEROY R. STANLEY

Surveyed APR 3 1973, by L.E. GOULD