


T. 27S. R. 7 W. W.M.

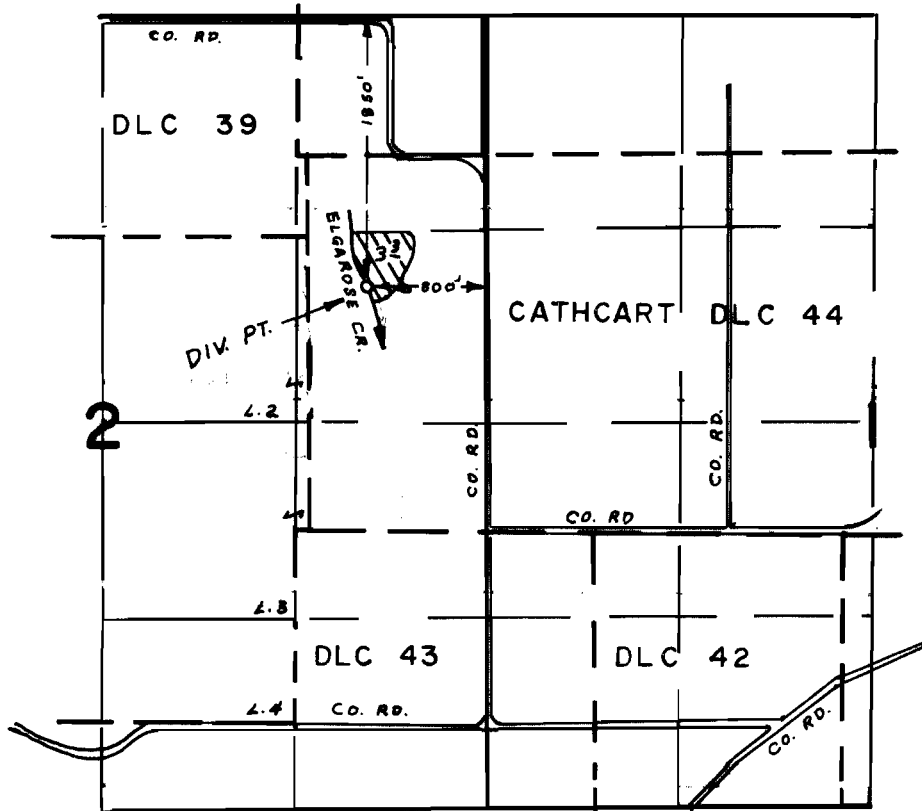

FINAL PROOF SURVEY UNDER

Application No. 46091 Permit No. 34439
IN NAME OF

WOODROW W. MILLER

Surveyed AUG. 26 1974, by L.H. NUNN