


T.26S., R.5&6W., W.M.

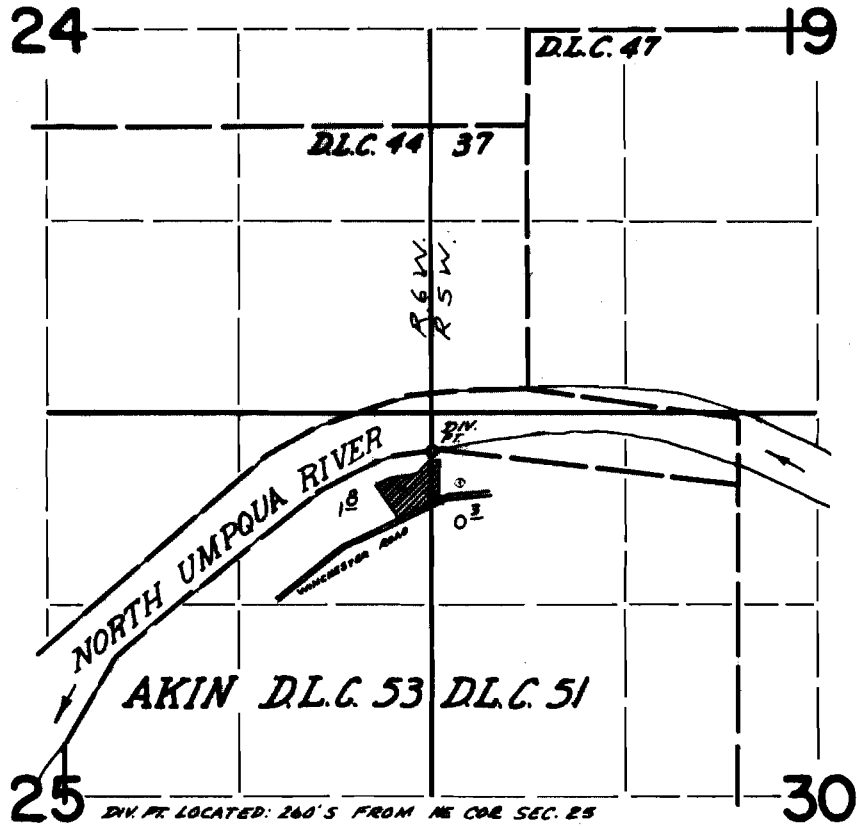

FINAL PROOF SURVEY
UNDER

Application No. 46357 Permit No. 34629
IN NAME OF

THOMAS C. HARTFIEL

Surveyed Sept. 11 1973, by D. Nooby