


~~DRAFTED WRONG~~

SEE A-50623

T. 25 S. R. 7 W. W.M.

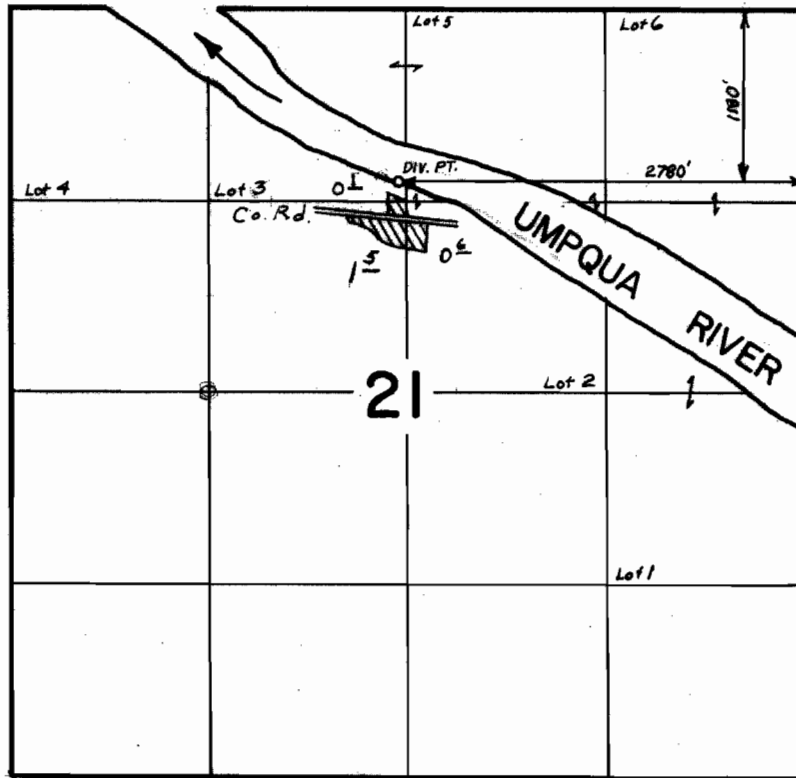

FINAL PROOF SURVEY UNDER

Application No. 47093 Permit No. 31585

IN NAME OF

BILL J. & LOLA J. MOSS

Surveyed APR. 4 1973, by L.E. GOULD