


T.30S.R.3W.W.M.

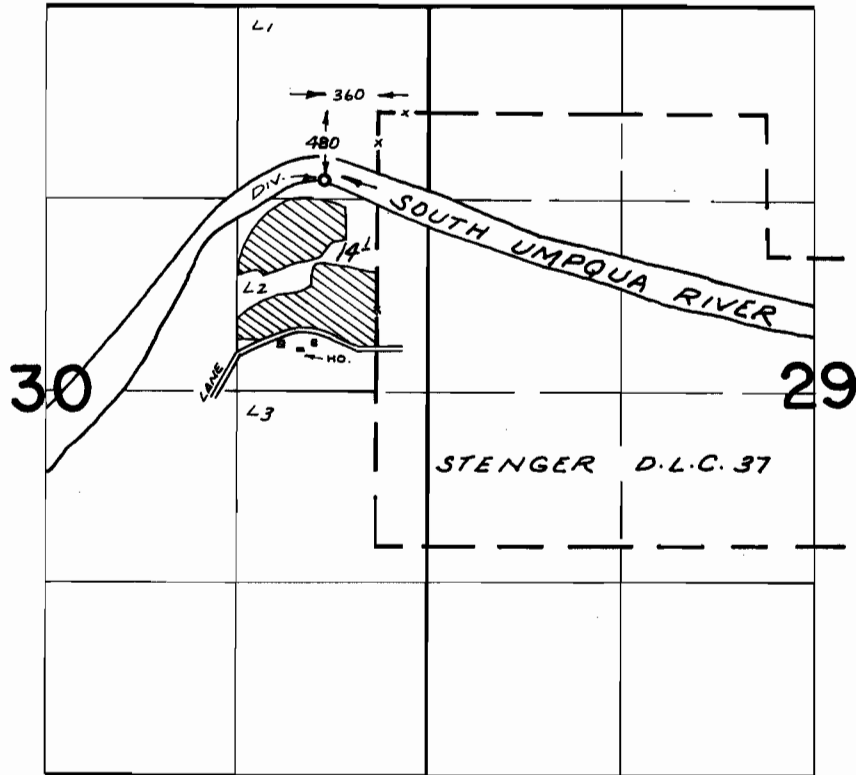

**FINAL PROOF SURVEY**  
UNDER

Application No. 48248 Permit No. 36230  
IN NAME OF

PAUL ROULEAU

Surveyed JUNE 11, 1973, by R. MUCKEN