


T. 36 S.R. 2 W. W.M

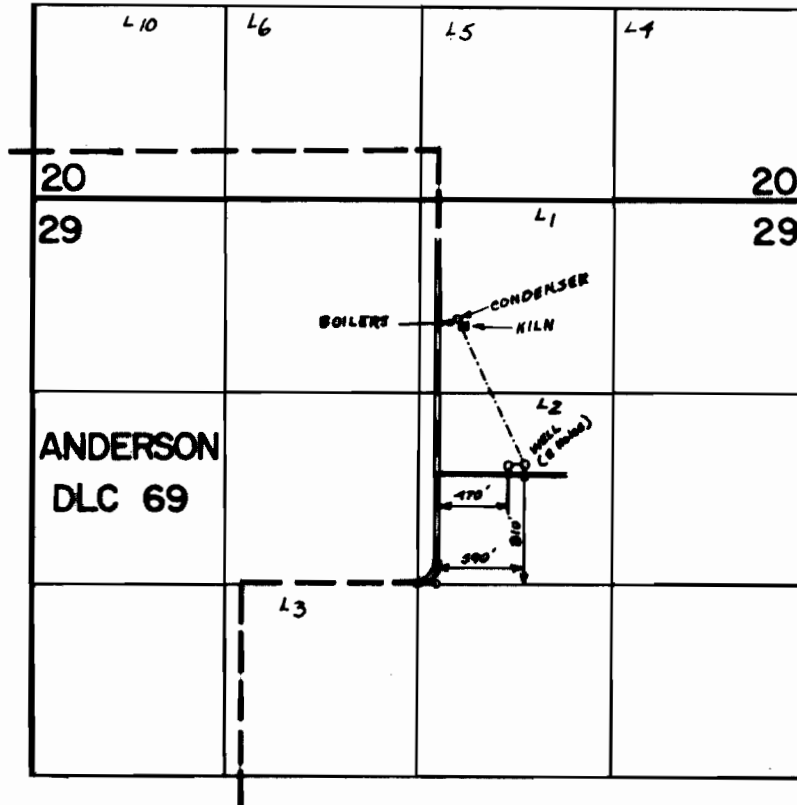

FINAL PROOF SURVEY UNDER

Application No. G-4940 Permit No. G-4663
IN NAME OF

STEVE WILSON LUMBER COMPANY

Surveyed OCT 9 1973, by R. G. MUCKEN