


T.36S. R.1W. W.M.

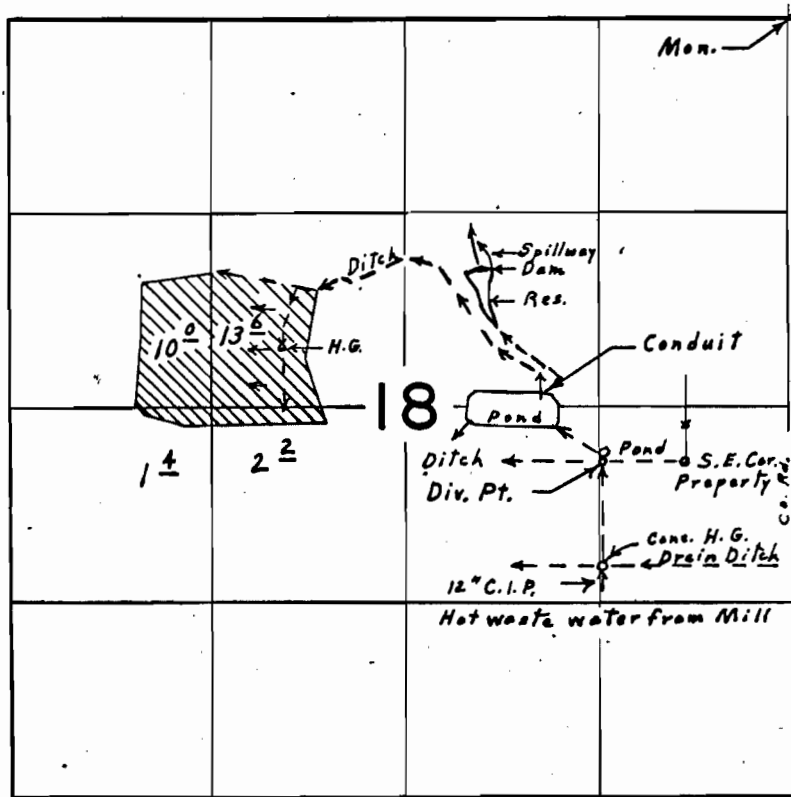

Div. Pt. Loc: 3000' S. & 1300' W. from N.E. Cor. Sec. 18

FINAL PROOF SURVEY UNDER

R-43121 R-4919
 Application No. 4.3.12.2. Permit No. 3.2.2.2.0
 IN NAME OF

OREGON STATE GAME COMMISSION

Surveyed Sept. 25, 1973, by L. E. Gould