


T.36 S. R.1 W. W.M.

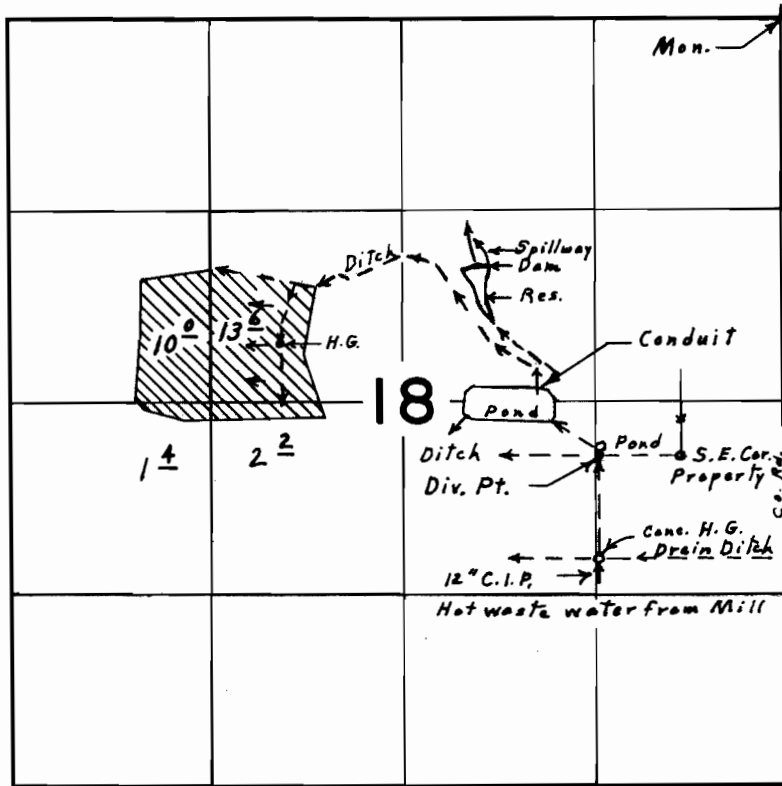

DIV. PT. LOC: 3000'S. & 1300' W. from N.E. Cor. Sec. 18

FINAL PROOF SURVEY UNDER

R-43121 R-4919
 Application No. 4.3.12.2. Permit No. 3.2.2.2.0
 IN NAME OF
OREGON STATE GAME COMMISSION
 Surveyed Sept. 25, 1973, by L. E. Gould