


T.38S.,R.4W.,W.M.

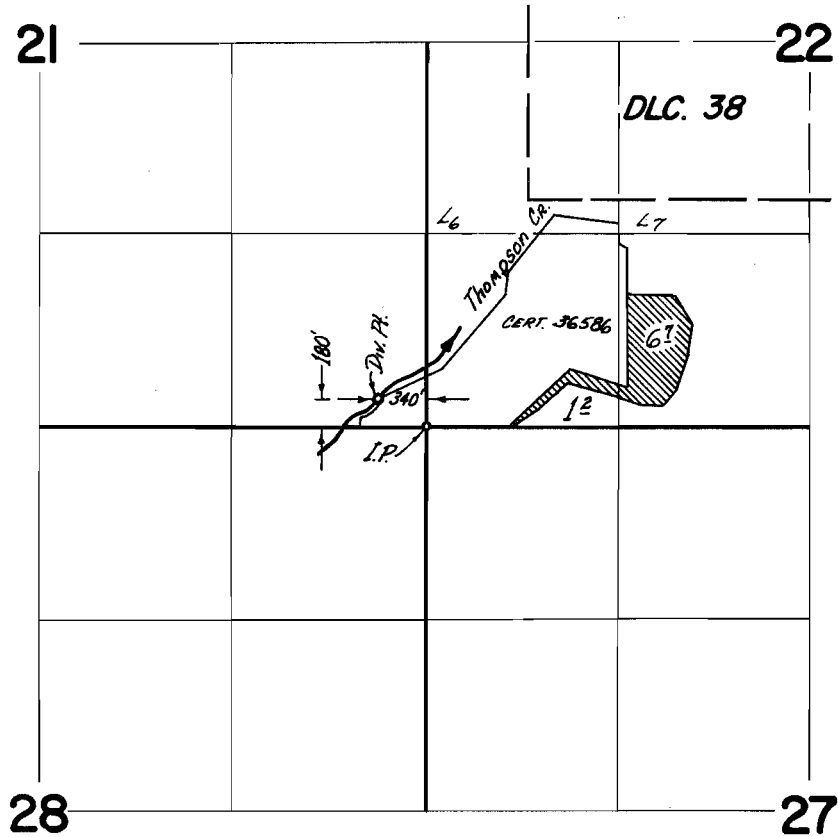

FINAL PROOF SURVEY
UNDER

Application No. 40536 Permit No. 30187
IN NAME OF

MARVIN R. ANDERSON

Surveyed Oct 15 1973, by D. NORBY