


T.38S.,R.4W.,W.M.

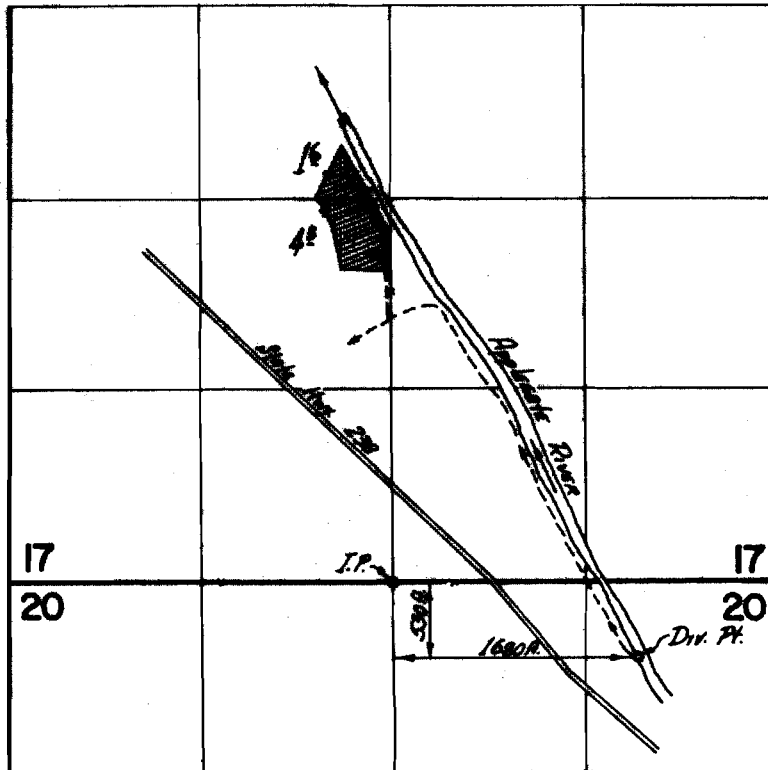

**FINAL PROOF SURVEY
UNDER**

Application No. 42000 Permit No. 31492
IN NAME OF

WILLIAM I. HARTSHORN, Jr.

Surveyed Oct. 10 1973, by D. Nacey