


T. 36S.R.2W.W.M.

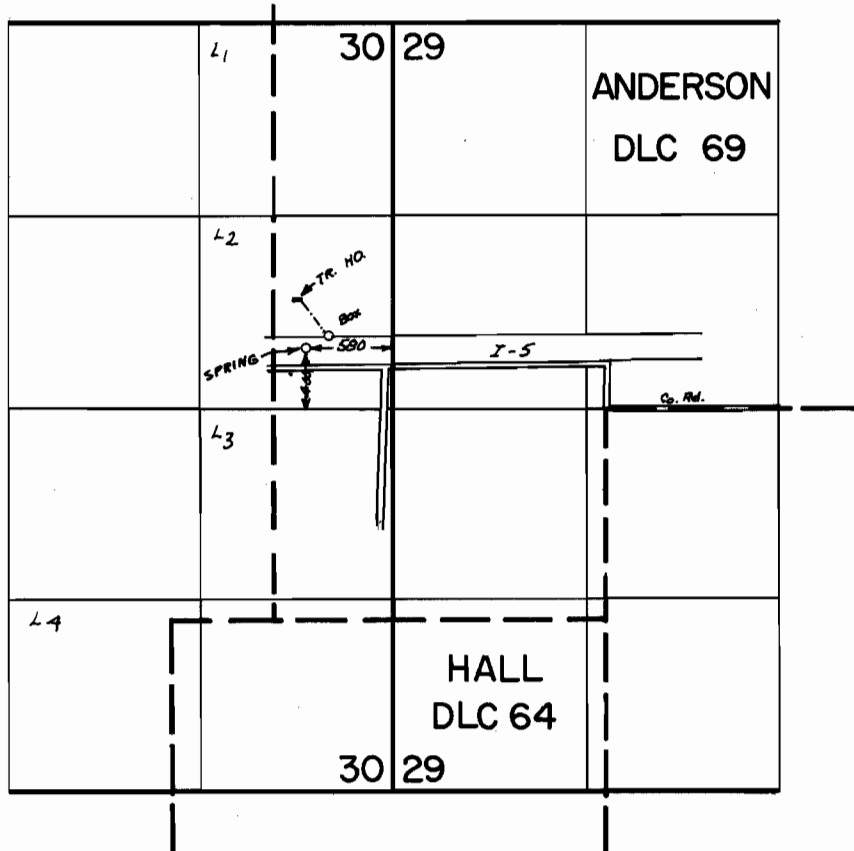

FINAL PROOF SURVEY UNDER

Application No. 42301 Permit No. 31632
IN NAME OF

Mitchell C. and Evelyn R. Hall

Surveyed OCT 10 1973, by R.G. MUCKEN