


T. 36S.R.4W.W.M.

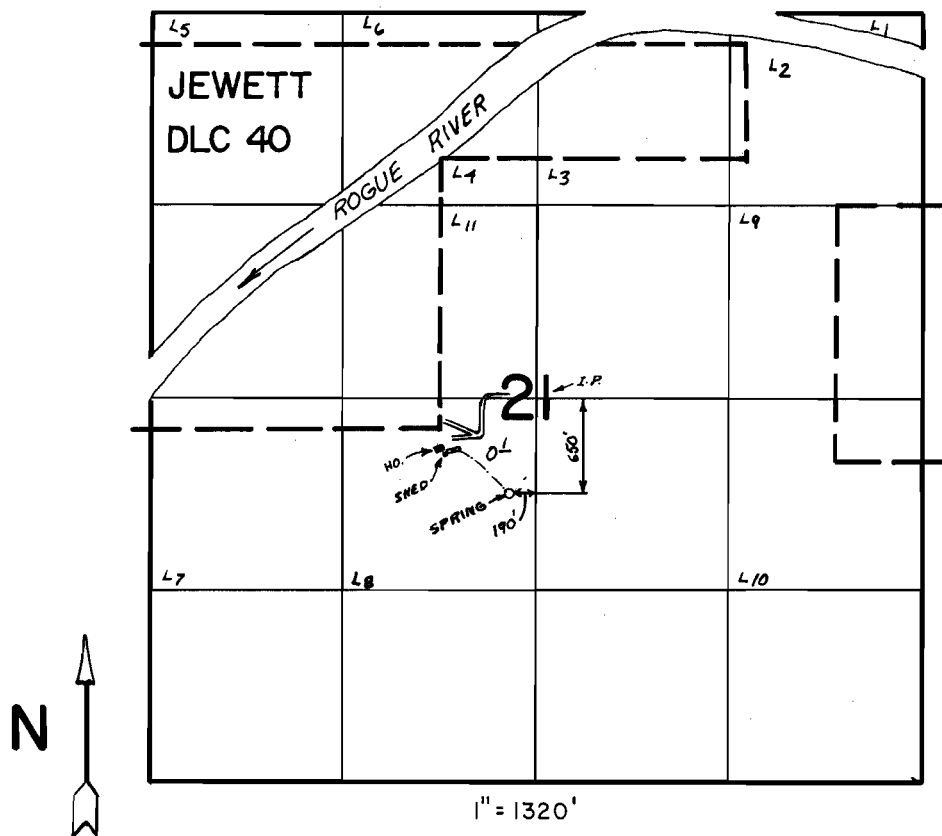

FINAL PROOF SURVEY UNDER

51365 38846
 Application No. 43006 Permit No. 32130
 IN NAME OF

GEORGE J. CALDWELL

Surveyed OCT 13 1973, by R. G. MUCKEN
 APRIL 22, 1983 B. S. JAMES