


T. 37 S. R. 3 & 4 W. W.M.

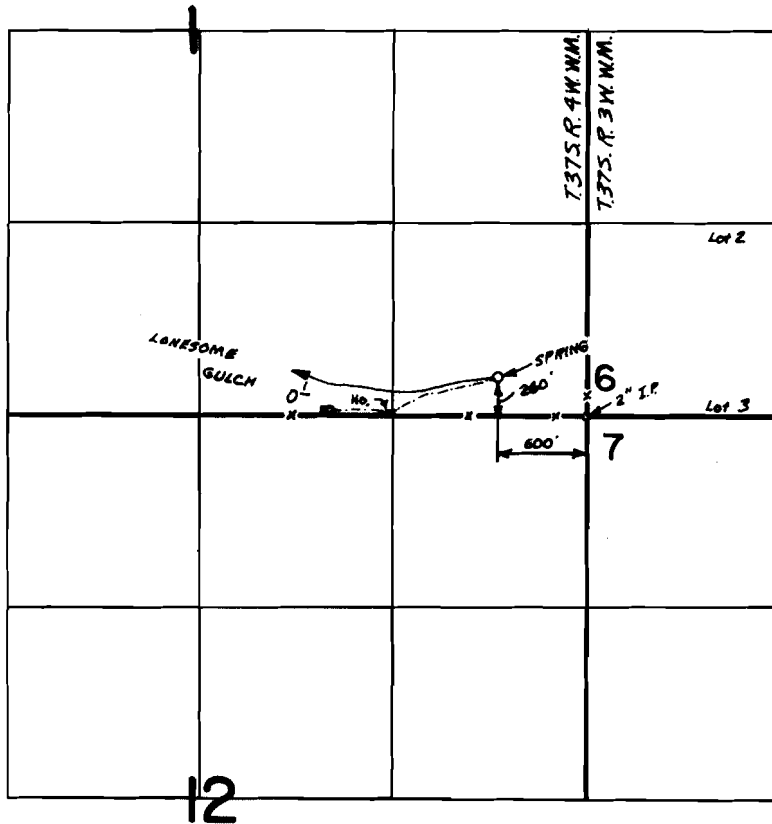

FINAL PROOF SURVEY UNDER

Application No. 43916 Permit No. 32821
IN NAME OF

EDWARD R. OR AUDREY J. PREFOUNTAINE

Surveyed OCT 10 1973, by R.G. MUCKEN