


T. 36S. R. 4W. W.M.

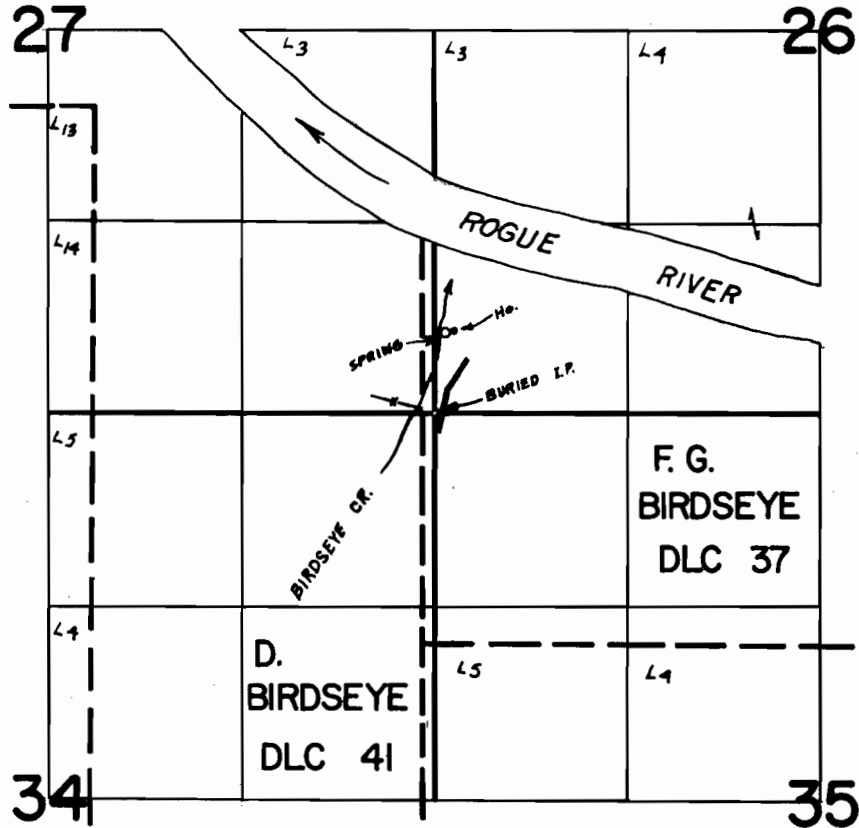

SPRING 550' N & 70' E FROM SW COR. SEC 26

FINAL PROOF SURVEY
UNDER

Application No. 44273 Permit No. 33070
IN NAME OF
R. C. GAIL

Surveyed OCT 15 1973, by R.G. MUCKEN