


T.38 & 39S., R.3W., W.M.

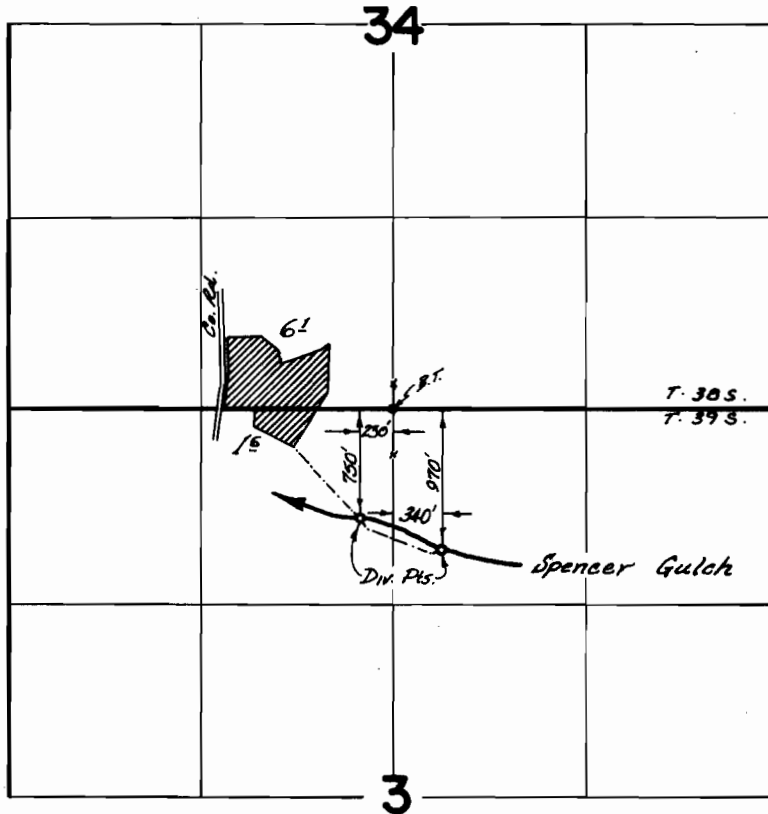

**FINAL PROOF SURVEY**  
UNDER

Application No. 46061 Permit No. 34256  
IN NAME OF

MELVIN W. PARKER & ERIC PETERSON

Surveyed Oct. 17 1973, by D. NORBY