


T. 37S.R.4W.W.M.

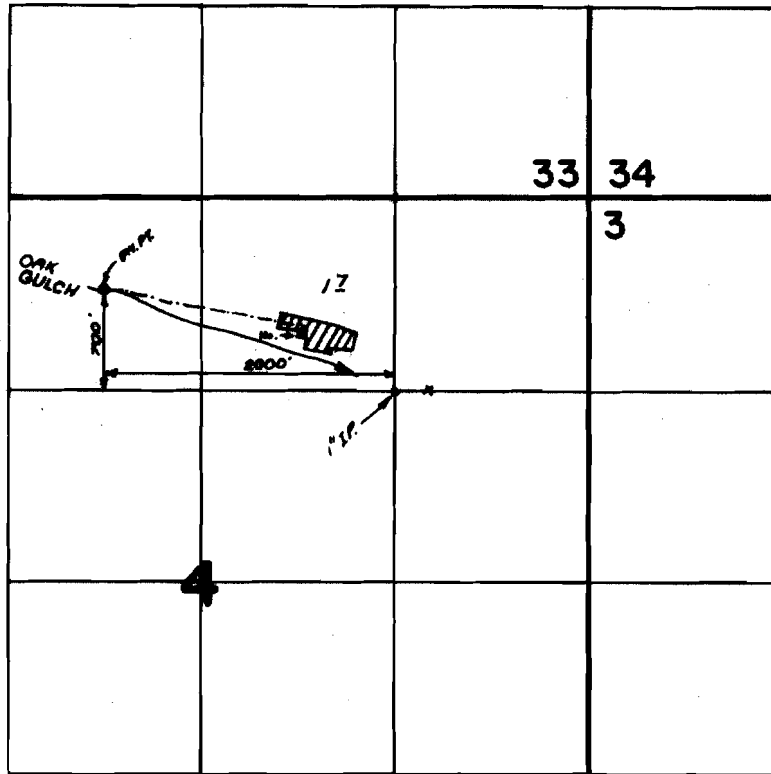

FINAL PROOF SURVEY UNDER

Application No. 46211 Permit No. 34527
IN NAME OF

MYRON L. SR. & ERRAWANNA KATZENBACH

Surveyed OCT 15 1973, by R.G. MUCKEN