


T38S.,R.4W.,W.M.

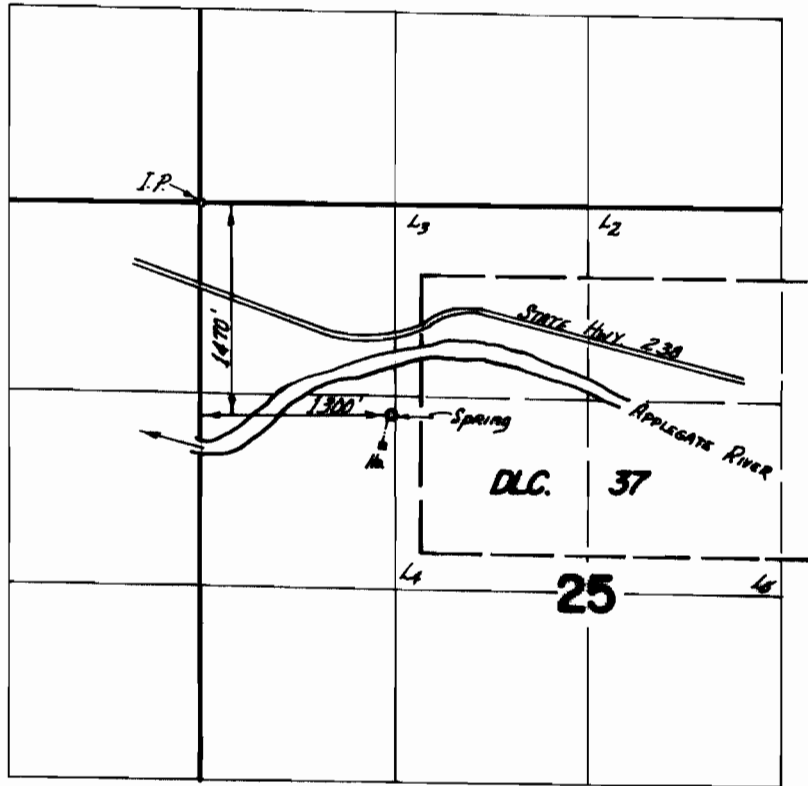

**FINAL PROOF SURVEY**  
UNDER

Application No. 46468 Permit No. 34712  
IN NAME OF

ANNA BERKHEISER

Surveyed Oct. 15 1973, by D. NORBY