


# T. 36 S. R. 3 W. W.M.

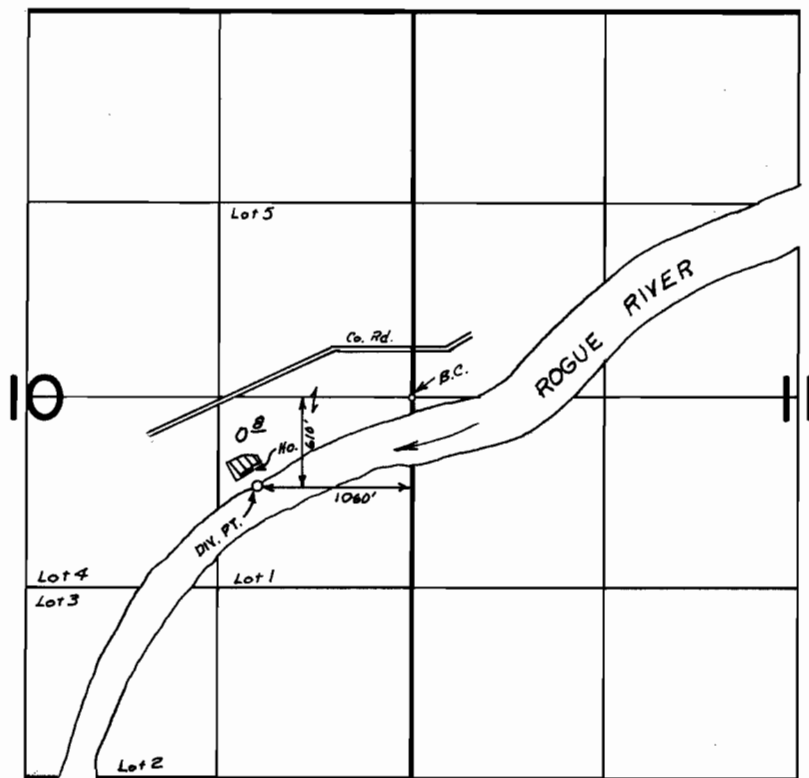

## FINAL PROOF SURVEY UNDER

Application No. 47866 Permit No. 35872  
IN NAME OF

L. D. JOSEPHSON

Surveyed OCT 9 1973, by R. G. MUCKEN