


MAP IN ERROR -
NO DLC LINES
IN THIS AREA
DLC LINES PERTAIN
TO T17S R5W

T.17S.R5W.W.M.

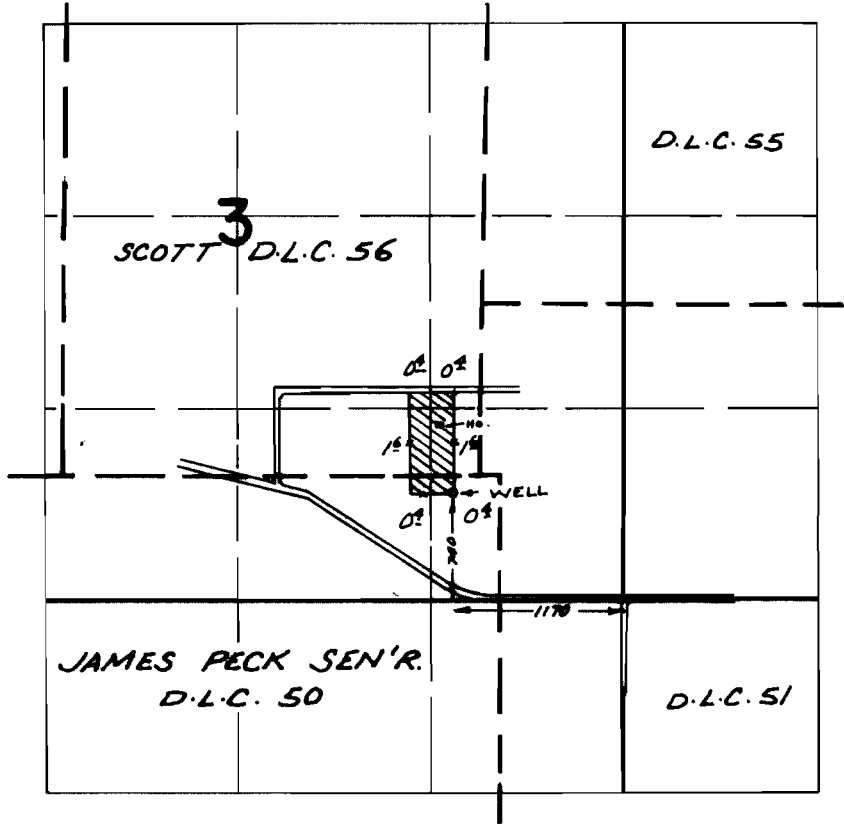

FINAL PROOF SURVEY UNDER

Application No. G-4200.. Permit No. G-4618
IN NAME OF

.....ALVIN H. LEE.....

Surveyed SEPT. 7, 1973., by R. MUGKEN