


T.17S., R.4W., W.M.

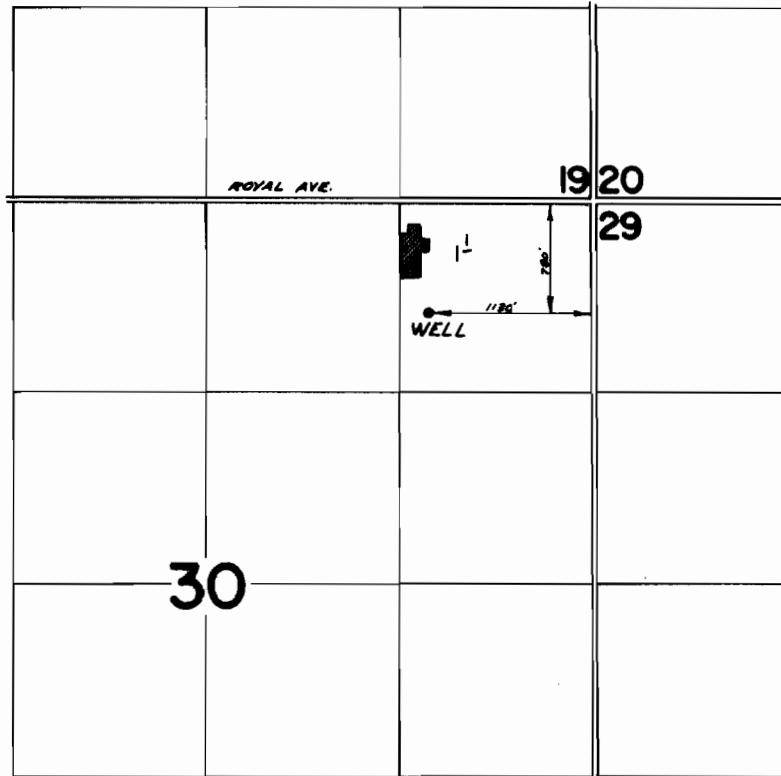

FINAL PROOF SURVEY
UNDER

Application No. G-4989 Permit No. G-4707
IN NAME OF

VERN C. KELSO

Surveyed June 15 1973, by D. Nooy