


T.17S.R.5W.W.M.

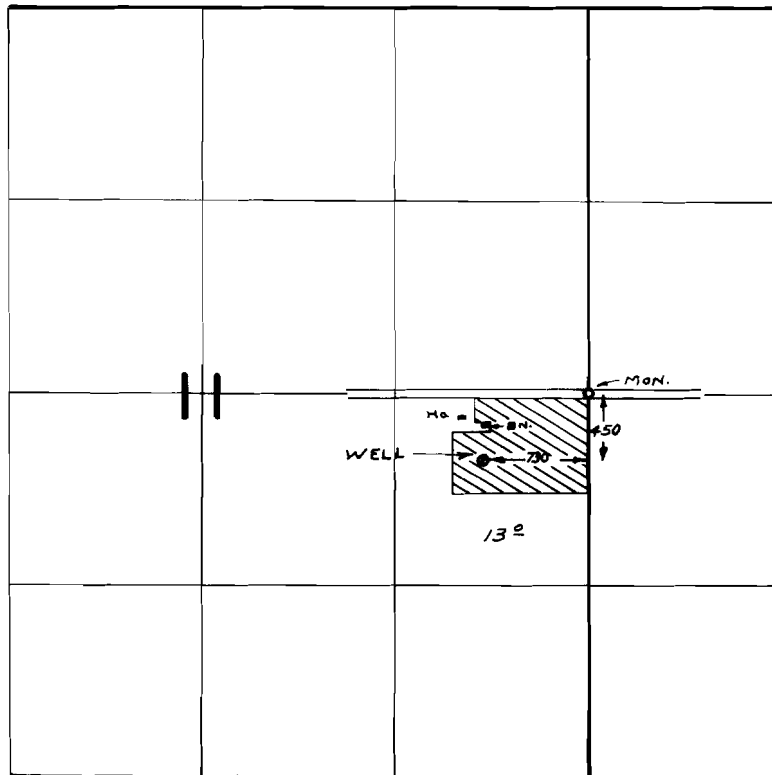

FINAL PROOF SURVEY
UNDER

Application No. G-5060 Permit No. G-4770
IN NAME OF

ROBERT O. E. CORLYSS A. BELL

Surveyed SEPT. 7, 1973, by R. MUCKEN