T. 15 S. R. 4 W. W. M.

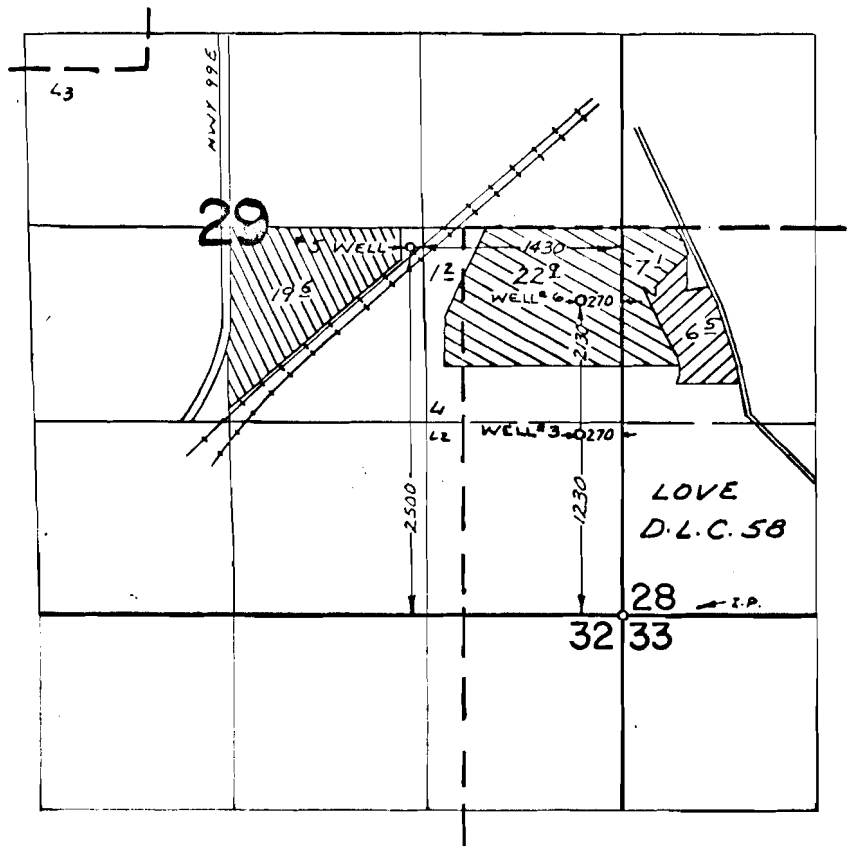

PERMIT G-5058 {PRIMARY WELL #3 — SUPPLEMENTAL WELL #6 —

PERMIT G-4807 —

FINAL PROOF SURVEY
UNDER

Application No. G-5092 G-5188 Permit No. G-4807 G-5058
IN NAME OF

JENS REERSLEY

Surveyed SEPT. 26 1973, by R. MUCKEN

DBQ-IJJ-269