


T. 27 S. R. 17 E. W.M.

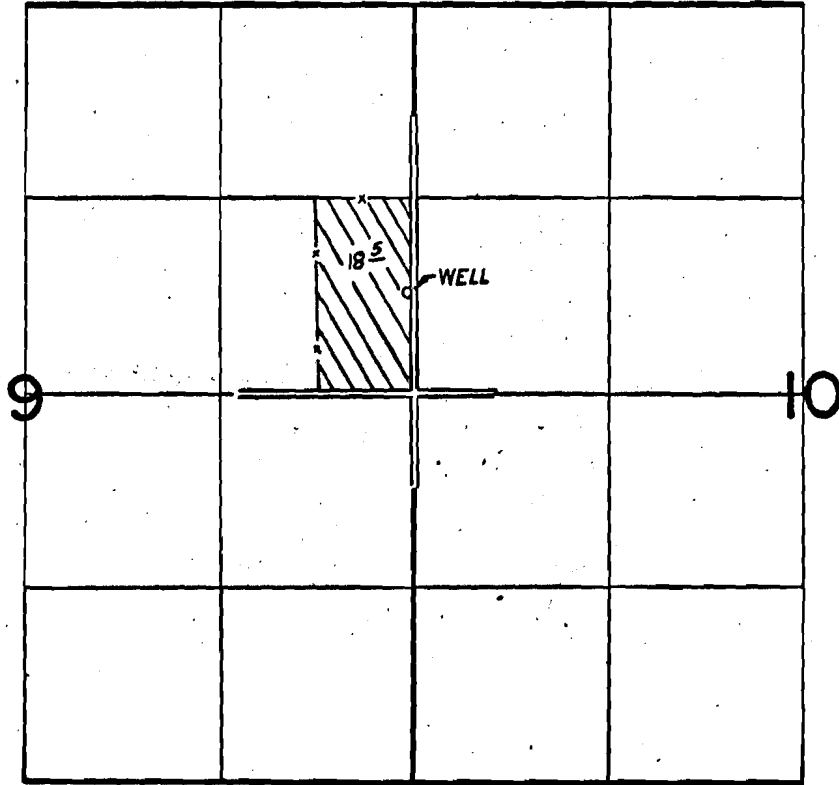

WELL 690' N & 20' W FROM E 1/4 COR. SEC. 9

FINAL PROOF SURVEY UNDER

Application No. G-5166 Permit No. G-4898
IN NAME OF

JESSIE MARTIN

Surveyed AUG 21 1973, by R.O. MUCKEN