


T.19S. R.11W. W.M.

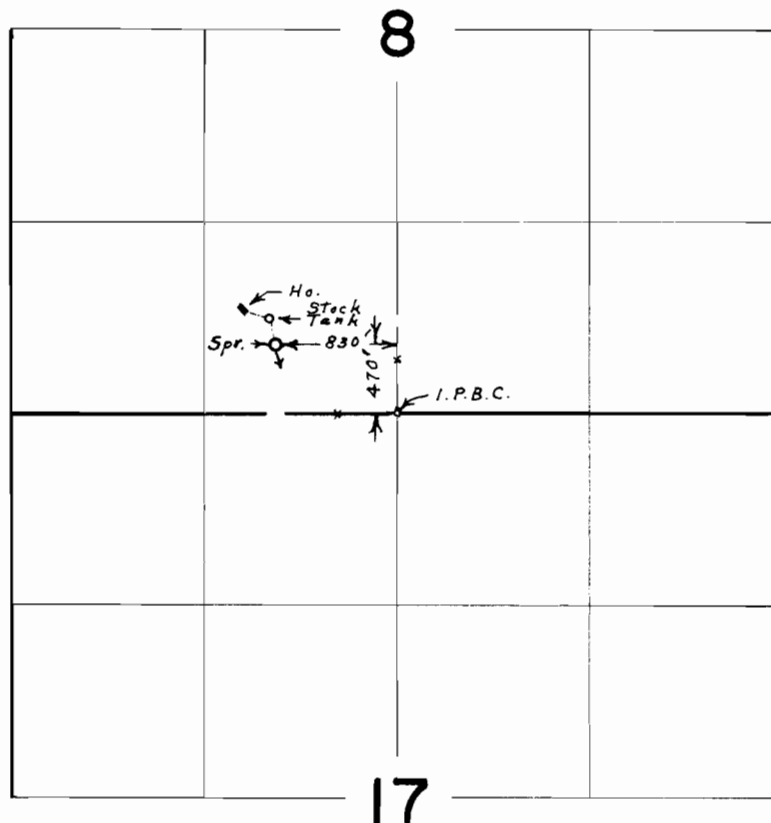

FINAL PROOF SURVEY
UNDER

Application No. 41344 Permit No. 30870
IN NAME OF

HARRY CARMEN OSGOOD

Surveyed July 19, 1973, by L. E. Gould