


# T. 18 & 19 S. R. 12 W. W.M.

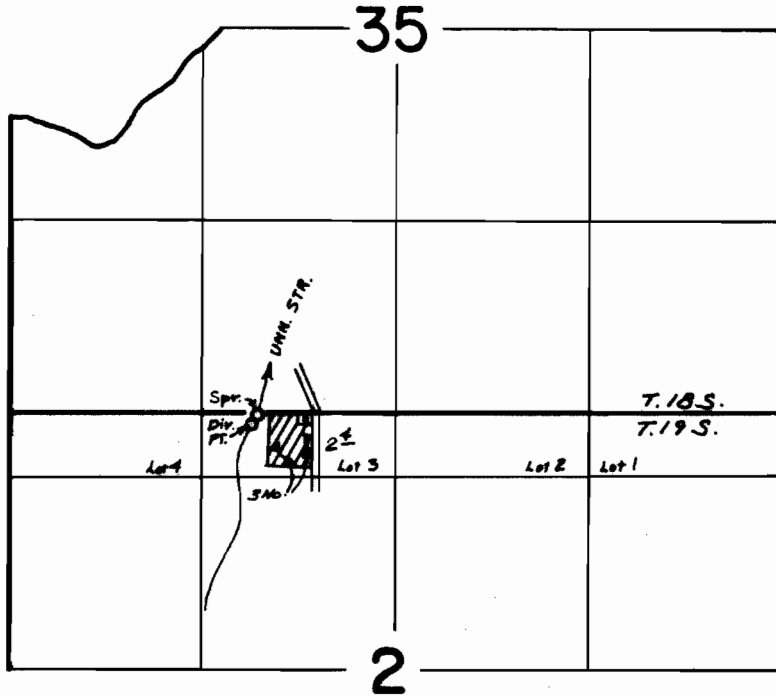

Dir. Pt. Located 88' South and 1650' East From NW Cor. Sec 2.  
Spr. Located 10' South and 1700' East From NW Cor. Sec 2

## FINAL PROOF SURVEY UNDER

Application No. 42826 Permit No. 32158  
IN NAME OF

FLOYD D. & RUTH DOLAND, SR.

Surveyed JULY 16 1973, by L.E. GOULD