


T.17S.R.1E.W.M.

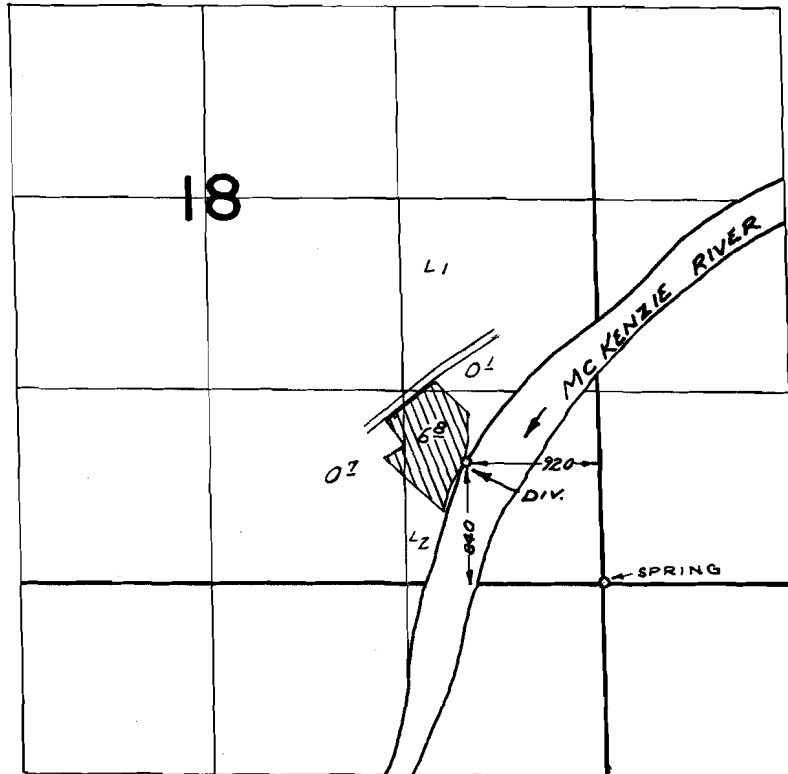

FINAL PROOF SURVEY UNDER

Application No. 44395 Permit No. 33162
IN NAME OF

W.L. VERENA, J. & W.S. HENDERSON.

Surveyed JUNE 27 1973, by T.V. PAUL