


T.15S., R.5W., W.M.

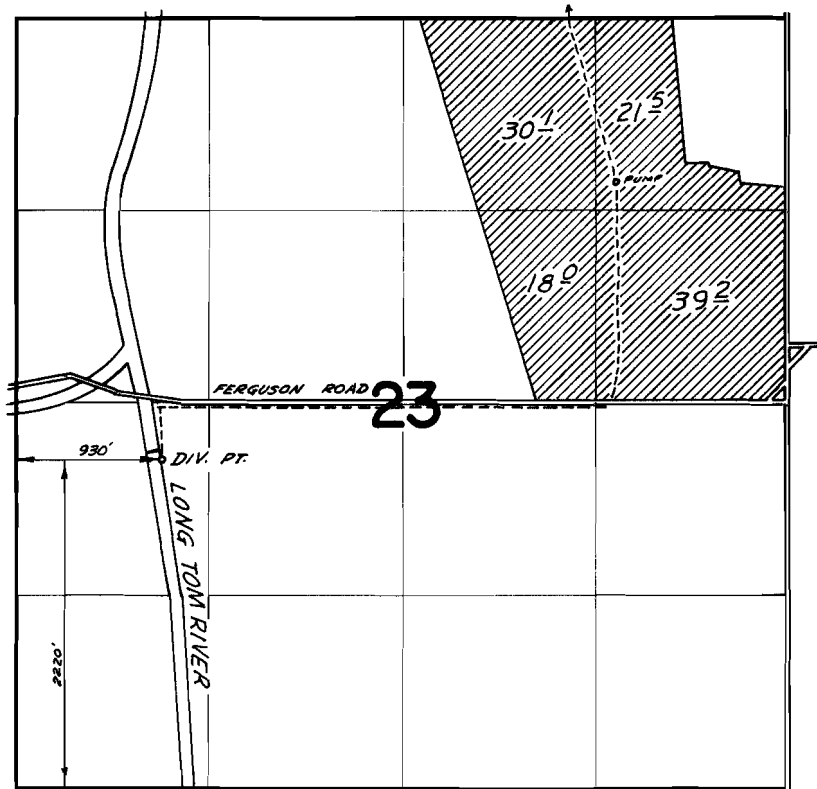

FINAL PROOF SURVEY
UNDER

Application No. 44575 Permit No. 33366
IN NAME OF

ELBERT L. STARNES

Surveyed Sept 20 19 73, by D. Norby