


T. 15 S., R. 1 W., W.M.

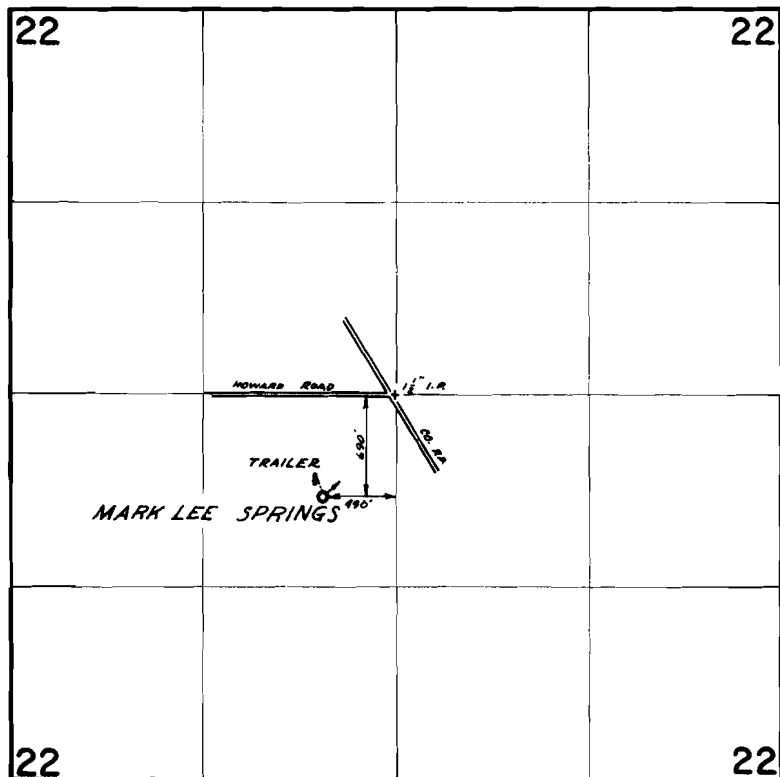

FINAL PROOF SURVEY
UNDER

Application No. 45689 Permit No. 34085
IN NAME OF

PAUL G. SNYDER

Surveyed MAY 1 1973, by D. NORBY