


T.16S., R.2W., W.M.

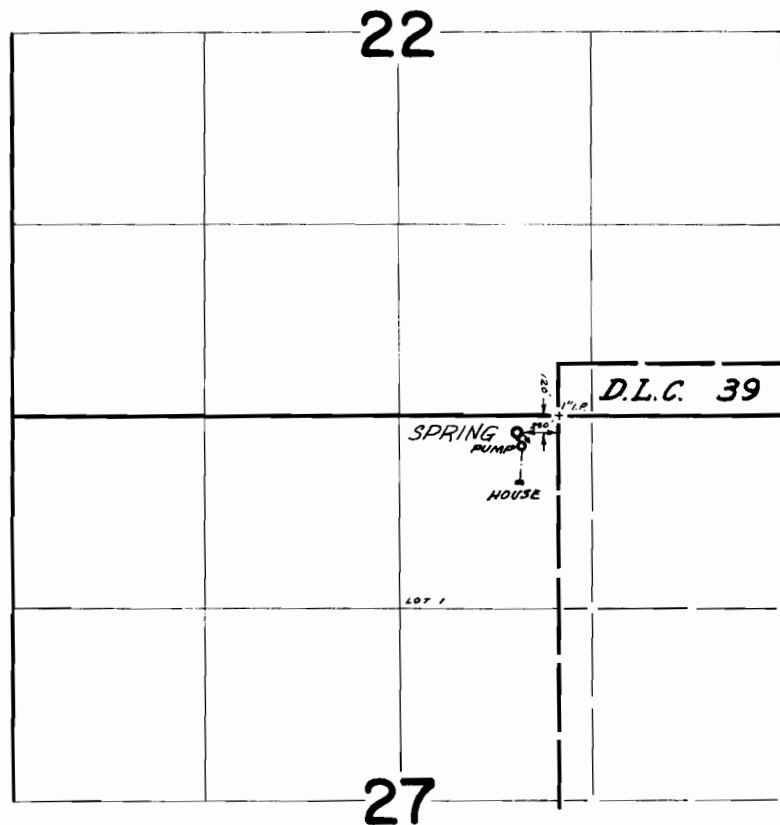

FINAL PROOF SURVEY
UNDER

Application No. 46963 Permit No. 35139
IN NAME OF

OPAL K. BROWN

Surveyed APRIL 30 1973, by D. NORBY