


T.17S., R.1W., W.M.

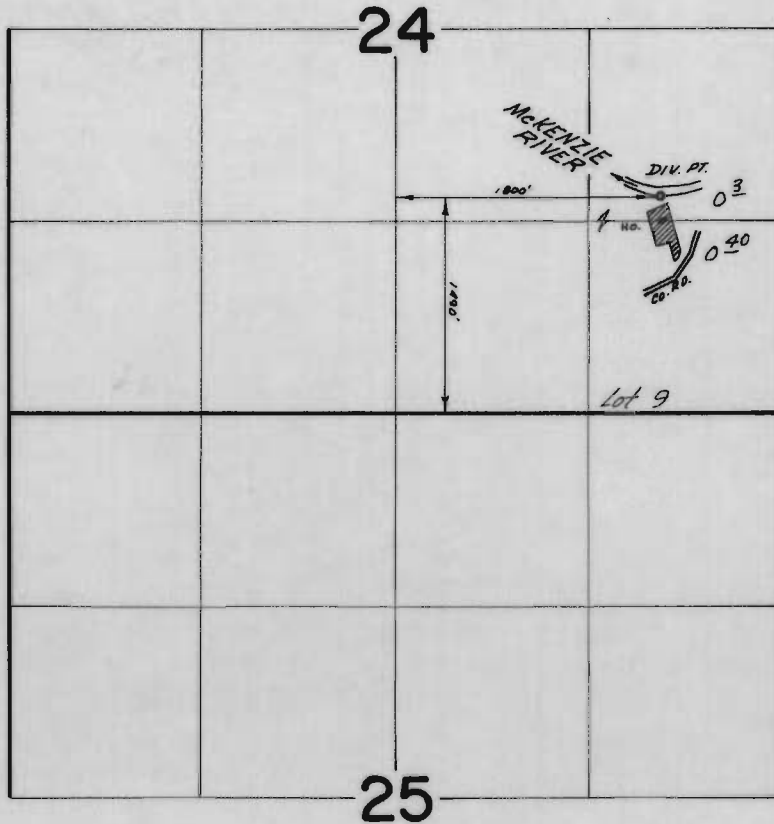

FINAL PROOF SURVEY
UNDER

Application No. 48092 Permit No. 36116
IN NAME OF

CLYDE E. & NORMA M. SATER

Surveyed May 2 1973, by D. Nobby